

MISSISSIPPI DEPARTMENT OF NATURAL RESOURCES

Bureau of Land and Water Resources

Southport Mall

P.O. Box 10631

Jackson, Mississippi 39209

WATER WELL DRILLERS LOG


SUNFLOWER
N 44
7/20/81

7/20/81 date well completed
Superwell Drilling firm name
Sumner county well located

CODED

LANDOWNER: <u>Ell & Band</u>	description of formations encountered	from	to
(mailing address)	Clay	6	26
WELL LOCATION:	Sand + Gravel	20	28
sec. <u>17</u> T <u>19</u> N R <u>4</u> E <u>4</u> miles <u>N</u> of <u>Andalucia</u> (distance) (direction) (nearest town)	Sand	28	58
WELL PURPOSE: (home, irrigation, municipal, industrial)	Sand + Gravel	58	113
WELL COMPLETION DATA: (1) diameter (inches) <u>16</u> (2) total depth (feet) <u>113'</u> (3) static water level (feet) <u>23</u> below above top of ground. (4) casing <u>Steel 73'</u> (material) (depth) <u>14</u> if telescope see back. (size) (5) screen <u>40 73'</u> (length) (depth to top) <u>16</u> <u>Steel</u> (size) (material) (6) pump <u>14 3000</u> (HP) (yield gpm) <u>Diesel</u> (type power) (7) electric log <u>No</u> (yes or no) <u>Plate</u> (organization running log) (8) how well bottom plugged			
DRILLERS REMARKS:			

CODED

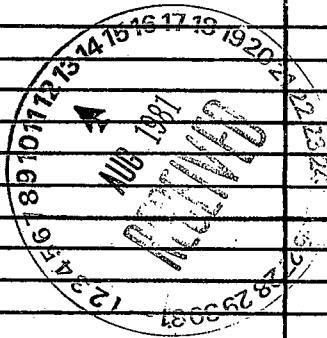

If well telescopes please sketch and show depths.

GROUND LEVEL

		X	

SECTION 12

Please indicate well location X.

ADDITIONAL INFORMATION

If more than one screen,
show locations of each on sketch.