

MISSISSIPPI DEPARTMENT OF NATURAL RESOURCES

Bureau of Land and Water Resources

Southport Mall

P.O. Box 10631

Jackson, Mississippi 39209 **CODED**

WATER WELL DRILLERS LOG

*John Patton Chesin*  
Irrigation Equipment, Inc.

*Sunflower*  
N 47  
417182

4/7/82 19                                   
date well completed                      firm name                      county well located

LANDOWNER: Clayton Barnwell

WELL #1

description of formations encountered

from

to

Clay	0	15'
Fine Sand	15'	55'
Coarse Sand	55'	60'
Coarse Sand & Small Grav	60'	98'
Clay/Coarse Sand/Gravel	98'	106'

(mailing address)

WELL LOCATION:

sec. 28 T. 19 <sup>(N)</sup> R. 4 <sup>(E)</sup>  
S W  
1/2 miles S<sup>W</sup> of Indianola  
(distance) (direction) (nearest town)

WELL PURPOSE: irrigation  
(home, irrigation, municipal, industrial)

WELL COMPLETION DATA:

- (1) diameter (inches) 12 3/4"
- (2) total depth (feet) 106'
- (3) static water level (feet) 26' <sup>below</sup> <sub>above</sub> top of ground.
- (4) casing Steel 66'  
(material) (depth)  
           if telescope see back.  
(size)
- (5) screen 40' 66'  
(length) (depth to top)  
12' steel  
(size) (material)
- (6) pump 80 1600  
(HP) (yield gpm)
- (7) electric log             
(yes or no)

            
(organization running log)

(8) how well bottom plugged steel Plate

DRILLERS REMARKS:           


DEPT. OF NATURAL RESOURCES  
BUREAU OF LAND & WATER RESOURCES

MAY - 3 1982

RECEIVED

If well telescopes please  
sketch and show depths.

GROUND LEVEL

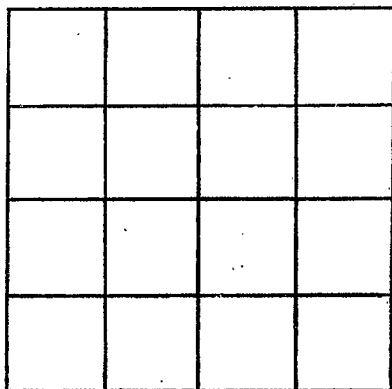

SECTION \_\_\_\_\_

Please indicate well location X.

ADDITIONAL INFORMATION

If more than one screen,  
show locations of each on sketch.