

MISSISSIPPI DEPARTMENT OF NATURAL RESOURCES

Bureau of Land and Water Resources

Southport Mall

P.O. Box 10631

Jackson, Mississippi 39209

WATER WELL DRILLERS LOG

CODED

John Patton Chism
Irrigation Equipment, Inc.

Sunflower
N 48
4/9/82

4/9/82 19 date well completed firm name Sunflower county well located

LANDOWNER: Clayton Barnwell
WELL # 2

description of formations encountered	from	to
Clay	0	20'
Fine Sand	20'	55'
Coarse Sand	55'	60'
Coarse sand/small gravel	60'	65'
Coarse sand/large gravel	65'	100'
Coarse sand/large gravel	100'	105'

(mailing address)
WELL LOCATION:
sec. 28 T. 19 N R. 4 E
S W
1/2 miles SWE of Indianola
(distance) (direction) (nearest town)

WELL PURPOSE: irrigation
(home, irrigation, municipal, industrial)

WELL COMPLETION DATA:
(1) diameter (inches) 12"
(2) total depth (feet) 105'
(3) static water level (feet) 26' below top of ground.
(4) casing steel, 65', (material) (depth)
(size) if telescope see back.
(5) screen 40', 65', (length) (depth to top)
12" Steel (size) (material)
(6) pump 80, 1600 (HP) (yield gpm)
Direct (type power)
(7) electric log (yes or no)
(organization running log)

(8) how well bottom plugged steel plate

DRILLERS REMARKS:


DEPT. OF NATURAL RESOURCES
BUREAU OF LAND & WATER RESOURCES

MAY - 3 1982

RECEIVED

If well telescopes please sketch and show depths.

GROUND LEVEL

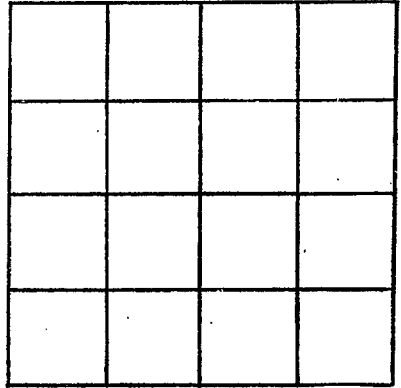

SECTION _____

Please indicate well location X.

ADDITIONAL INFORMATION

If more than one screen, show locations of each on sketch.