

MISSISSIPPI DEPARTMENT OF NATURAL RESOURCES

Bureau of Land and Water Resources

Southport Mall

P.O. Box 10631

Jackson, Mississippi 39209

WATER WELL DRILLERS LOG

CODED

John Patton Chism
 Sunflower Equipment, Inc.

Sunflower

Sunflower
 N 49
 4/11/82

4/11/82

date well completed

firm name

county well located

LANDOWNER: Clayton Barnwell

WELL # 3

description of formations encountered

from

to

Clay	0'	22'
Fine Sand	22'	50'
Coarse sand/small gravel	50'	60'
Coarse sand/small gravel	60'	68'
Coarse sand/large gravel	68'	106'

(mailing address)

WELL LOCATION:

sec. 28 T. 19 N. R. 4 E
 S W
 1/2 miles SE of Indianola
 (distance) (direction) (nearest town)

WELL PURPOSE: irrigation
 (home, irrigation, municipal, industrial)

WELL COMPLETION DATA:

- (1) diameter (inches) 12"
- (2) total depth (feet) 106'
- (3) static water level (feet) 26' below top of ground.
- (4) casing Steel, 66' (material) (depth)
 (size) if telescope see back.
- (5) screen 40' 66' (length) (depth to top)
 12" steel (size) (material)
- (6) pump 80 1600 (HP) (yield gpm)
 Diesel (type power)
- (7) electric log (yes or no)
 (organization running log)

(8) how well bottom plugged steel plate

DEPT. OF NATURAL RESOURCES
 BUREAU OF LAND & WATER RESOURCES


MAY - 3 1982

RECEIVED

DRILLERS REMARKS:

If well telescopes please sketch and show depths.

GROUND LEVEL

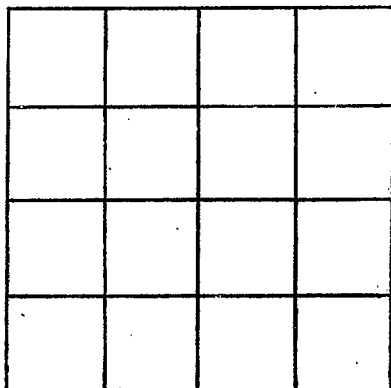

SECTION _____

Please indicate well location X.

ADDITIONAL INFORMATION

If more than one screen,
show locations of each on sketch.