

MISSISSIPPI DEPARTMENT OF NATURAL RESOURCES

Bureau of Land and Water Resources

Southport Mall

P.O. Box 10631

Jackson, Mississippi 39209

WATER WELL DRILLERS LOG

CODED

Sumflow
 N61
 3/10/82

Gw 4561
 SE/SE, Sec. 5
 Elev. 115

3-10-1982 date well completed
 Open Well firm name
 Sumflow county well located

LANDOWNER: <i>Mum Hill</i>	description of formations encountered	from	to
(mailing address)	<i>Fin Sand</i>	0	32
	<i>Sand</i>	32	48
	<i>Sand & Gravel</i>	48	111
WELL LOCATION: sec. <u>5</u> T <u>19</u> N R <u>4</u> E S W <u>3</u> miles <u>NW</u> of <u>Indianola</u> (distance) (direction) (nearest town)			
WELL PURPOSE: (home, irrigation, municipal, industrial)			
WELL COMPLETION DATA: (1) diameter (inches) <u>16"</u> (2) total depth (feet) <u>111</u> (3) static water level (feet) <u>14</u> below above top of ground. (4) casing <u>Steel</u> , <u>71</u> (material) (depth) <u>16"</u> If telescope see back. (size) (5) screen <u>40"</u> , <u>71</u> (length) (depth to top) <u>16"</u> , <u>Mild Steel</u> (size) (material) (6) pump <u>60</u> , <u>3000</u> (HP) (yield gpm) <u>diesel</u> (type power) (7) electric log <u>No</u> (yes or no) (organization running log)			
(8) how well bottom plugged <u>Plate</u>			
DRILLERS REMARKS:			


DEPT. OF NATURAL RESOURCES
 BUREAU OF LAND & WATER RESOURCES

JUN 30 1982

RECEIVED

If well telescopes please sketch and show depths.

GROUND LEVEL

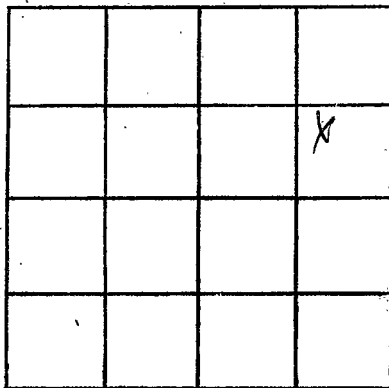

SECTION 5

Please indicate well location X.

ADDITIONAL INFORMATION

If more than one screen,
show locations of each on sketch.