

MISSISSIPPI DEPARTMENT OF NATURAL RESOURCES

Bureau of Land and Water Resources

Southport Mall

P.O. Box 10631

Jackson, Mississippi 39209

WATER WELL DRILLERS LOG

CODED

Sumflow
N 52
3/15/82

Gw 4554
NW/SW, Sec. 17
Elev. 115

3-15 19 82 Oyer Well Sumflow
date well completed firm name county well located

LANDOWNER: Nisam Hill

description of formations encountered from to

(mailing address)

fine sand 0 30
sand 30 70
sand & gravel 70 100

WELL LOCATION:

sec. 17 T. 19 N R. 4 E
S W
2 miles N of Indianola
(distance) (direction) (nearest town)

WELL PURPOSE:

(home, irrigation, municipal, industrial)

WELL COMPLETION DATA:

- (1) diameter (inches) 16
- (2) total depth (feet) 108
- (3) static water level (feet) 14 below above top of ground.
- (4) casing Steel, 108,
(material) (depth)
16 if telescope see back.
(size)
- (5) screen 40
(length) (depth to top)
16, Mild Steel
(size) (material)
- (6) pump Ho, 2000
(HP) (yield gpm)
electric
(type power)
- (7) electric log No
(yes or no)

(organization running log)

(8) how well bottom plugged Plate

DRILLERS REMARKS:


DEPT. OF NATURAL RESOURCES
BUREAU OF LAND & WATER RESOURCES

JUN 30 1982

RECEIVED

If well telescopes please sketch and show depths.

GROUND LEVEL

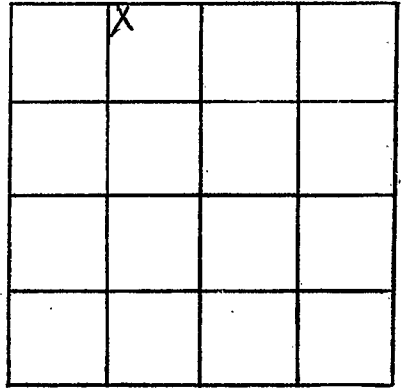

SECTION 17

Please indicate well location X.

ADDITIONAL INFORMATION

If more than one screen,
show locations of each on sketch.