

MISSISSIPPI DEPARTMENT OF NATURAL RESOURCES
Bureau of Land and Water Resources
 Southport Mall
 P.O. Box 10631
 Jackson, Mississippi 39209

WATER WELL DRILLERS LOG

CODED

Shupflow
N 55
419182

4-9 19 82 Oyer Well Shupflow
 date well completed firm name county well located

LANDOWNER: Jack Griffith
 (mailing address)

description of formations encountered	from	to
Clay	0	10
Fine Sand	10	28
Sand	28	38
Sand & Gravel	38	103

WELL LOCATION:
 sec. 10 T 19 S R 4 E
3 miles N of Indianola
 (distance) (direction) (nearest town)

WELL PURPOSE:
 (home, irrigation, municipal, industrial)

- WELL COMPLETION DATA:
- (1) diameter (inches) 16
 - (2) total depth (feet) 103
 - (3) static water level (feet) 17 below above top of ground.
 - (4) casing Steel 63
 (material) (depth)
16 if telescope see back.
 (size)
 - (5) screen 40 63
 (length) (depth to top)
16 mild steel
 (size) (material)
 - (6) pump 60 3000
 (HP) (yield gpm)
electric
 (type power)
 - (7) electric log NO
 (yes or no)
 (organization running log)
 - (8) how well bottom plugged Plate


DRILLERS REMARKS:

DEPT. OF NATURAL RESOURCES
 BUREAU OF LAND & WATER RESOURCES

SEP 30 1982
RECEIVED

If well telescopes please sketch and show depths.

GROUND LEVEL

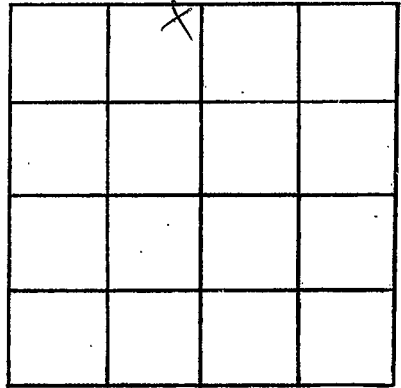

SECTION 10

Please indicate well location X.

ADDITIONAL INFORMATION

If more than one screen,
show locations of each on sketch.