

MISSISSIPPI DEPARTMENT OF NATURAL RESOURCES

Bureau of Land and Water Resources

Southport Mall

P.O. Box 10631

Jackson, Mississippi 39209

WATER WELL DRILLERS LOG

CODED

Sample
N56
4/1/82

19 Sept date well completed

Wells + Inc firm name

Sample county well located

LANDOWNER: W. E. Carter

description of formations encountered

from

to

Indianola, Md

WELL #1

(mailing address)

WELL LOCATION:

sec. 14 T 19 (N) R 4 E
S (W)
3 miles SE of Indianola
(distance) (direction) (nearest town)

WELL PURPOSE:

(home, irrigation, municipal, industrial)

WELL COMPLETION DATA:

- (1) diameter (inches) 16"
- (2) total depth (feet) 24110
- (3) static water level (feet) 24 below above top of ground.
- (4) casing steel (material), 20 (depth),
16 (size) if telescope see back.
- (5) screen 40 (length), 70 (depth to top),
16 (size), mild steel (material)
- (6) pump 60 (HP), 3000 (yield gpm),
electric (type power)
- (7) electric log no (yes or no)

(organization running log)

(8) how well bottom plugged plate

DRILLERS REMARKS:


DEPT. OF NATURAL RESOURCES
BUREAU OF LAND & WATER RESOURCES

SEP 30 1982

RECEIVED

If well telescopes please sketch and show depths.

GROUND LEVEL

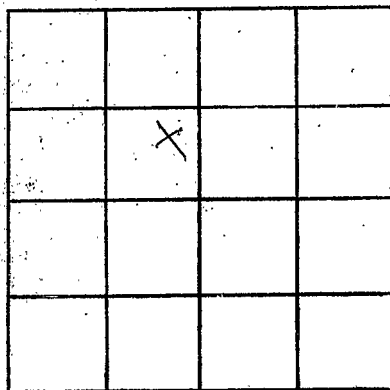

SECTION 14

Please indicate well location X.

ADDITIONAL INFORMATION

If more than one screen,
show locations of each on sketch.