

MISSISSIPPI DEPARTMENT OF NATURAL RESOURCES

Bureau of Land and Water Resources

Southport Mall

P.O. Box 10631

Jackson, Mississippi 39209

CODED

WATER WELL DRILLERS LOG

Sunflower  
N 58  
4/20/82

GW 5160

NW/ NW, Sec. 14

Elev. 115

19 Dyer Well

firm name

Sunflower Co.  
 county well located

date well completed

LANDOWNER:

Bobby Shepard  
Indianola, ms  
 (mailing address)

description of formations encountered

from

to

<u>Clay</u>	<u>0</u>	<u>21</u>
<u>Fine Sand</u>	<u>21</u>	<u>47</u>
<u>Sand</u>	<u>47</u>	<u>56</u>
<u>Sand + gravel</u>	<u>56</u>	<u>103</u>

WELL LOCATION:

sec. 14 T 19 N 5 R 3 E W  
3 miles NE of Indianola  
 (distance) (direction) (nearest town)

WELL PURPOSE:

(home, irrigation, municipal, industrial)

WELL COMPLETION DATA:

- (1) diameter (inches) 10"
- (2) total depth (feet) 103
- (3) static water level (feet) 22 below above top of ground.
- (4) casing PVC, 73,  
 (material) (depth)  
 (size) if telescope see back.
- (5) screen 20, 20  
 (length) (depth to top)  
10", PVC  
 (size) (material)
- (6) pump 7 1/2, 250  
 (HP) (yield gpm)  
electric  
 (type power)
- (7) electric log no  
 (yes or no)  
no  
 (organization running log)
- (8) how well bottom plugged Cap

DEPT. OF NATURAL RESOURCES  
 BUREAU OF LAND & WATER RESOURCES


FEB - 3 1983

RECEIVED

DRILLERS REMARKS:

If well telescopes please sketch and show depths.

GROUND LEVEL

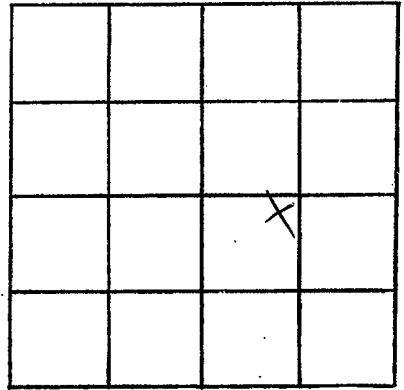

SECTION 14

Please indicate well location X.

ADDITIONAL INFORMATION

A series of horizontal lines for writing additional information.

If more than one screen, show locations of each on sketch.