

MISSISSIPPI DEPARTMENT OF NATURAL RESOURCES

Bureau of Land and Water Resources

Southport Mall

P.O. Box 10631

Jackson, Mississippi 39209

CODED

Elev. 120 WATER WELL DRILLERS LOG

SUNFLOWER

N 60

3/14/83

GW 4557

SW/NW, Sec. 9

Elev. 120

March 14 1983  
date well completed

Larry's wells pump  
firm name

Sunflower  
county well located

LANDOWNER:

Hiram Hill

description of formations encountered

from

to

Indiana, Mo.  
(mailing address)

clay	0	20
5' sand	20	60
Sand & gravel	60	115

WELL LOCATION:

sec. 9 T 19 N R 4 E  
S W  
4 miles N of Indiana  
(distance) (direction) (nearest town)

WELL PURPOSE:

(home, irrigation, municipal, industrial)

WELL COMPLETION DATA:

- (1) diameter (inches) 16"
- (2) total depth (feet) 115'
- (3) static water level (feet) 21 below above top of ground.
- (4) casing steel 75'  
(material) (depth)  
(size) if telescope see back.
- (5) screen 40' 75'  
(length) (depth to top)  
16" steel  
(size) (material)
- (6) pump 160 1400  
(HP) (yield gpm)  
(type power)
- (7) electric log NO  
(yes or no)

CODED

(organization running log)

- (8) how well bottom plugged Steel Plate

DRILLERS REMARKS:


DEPT. OF NATURAL RESOURCES  
BUREAU OF LAND & WATER RESOURCES

MAY 5 - 1983

RECEIVED

If well telescopes please sketch and show depths.

GROUND LEVEL

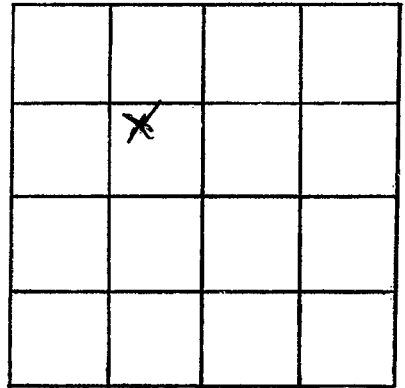

SECTION 9

Please indicate well location X.

ADDITIONAL INFORMATION

If more than one screen,  
show locations of each on sketch.