

MISSISSIPPI DEPARTMENT OF NATURAL RESOURCES

Bureau of Land and Water Resources

Southport Mall

P.O. Box 10631

Jackson, Mississippi 39209

WATER WELL DRILLERS LOG

CODED

SYNFLOWER
1461
4/83

date well completed 19

Sunflower

firm name

Sunflower

county well located

LANDOWNER: *Willie M. Pitts*

description of formations encountered

from

to

(mailing address)

WELL LOCATION:

sec. 4 T. 19 N. R. 4 E. of Indianola
S W
 (distance) miles (direction) (nearest town)

<i>Clay</i>	<i>0</i>	<i>24</i>
<i>fine sand</i>	<i>24</i>	<i>30</i>
<i>Sand</i>	<i>30</i>	<i>50</i>
<i>Fine Sand</i>	<i>50</i>	<i>65</i>
<i>Small Gravel</i>	<i>65</i>	<i>108</i>

WELL PURPOSE:

(home, irrigation, municipal, industrial)

WELL COMPLETION DATA:

- (1) diameter (inches) 16
- (2) total depth (feet) 108
- (3) static water level (feet) 24' below top of ground.
- (4) casing steel, 168' (material) (depth)
(size) if telescope see back.
- (5) screen 40' (length) (depth to top)
16" (size) steel (material)
- (6) pump 60 (HP) 1200 (yield gpm)
diesel (type power)
- (7) electric log no (yes or no)
(organization running log)
- (8) how well bottom plugged plates

CODED

DEPT. OF NATURAL RESOURCES
 BUREAU OF LAND & WATER RESOURCES


MAY 9 - 1983

RECEIVED

DRILLERS REMARKS:

If well telescopes please sketch and show depths.

GROUND LEVEL

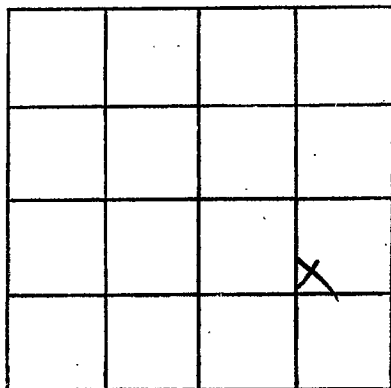

SECTION 4

Please indicate well location X.

ADDITIONAL INFORMATION

If more than one screen, show locations of each on sketch.