

MISSISSIPPI DEPARTMENT OF NATURAL RESOURCES

Bureau of Land and Water Resources

Southport Mall

P.O. Box 10631

Jackson, Mississippi 39209 **CODED**

WATER WELL DRILLERS LOG

Sunflower
N 64
3/31/82

3/31 19 82 Water Well Sunflower
date well completed firm name county well located

LANDOWNER: Thomas Allison

description of formations encountered

from

to

(mailing address)

WELL LOCATION:

sec. 1 T. 19 (N) S. R. 4 (E) (W)
2 miles SW of Sunflower
(distance) (direction) (nearest town)

Clay	0	26
Fine Sand	28	32
Sand	32	48
Sand & Gravel	48	93

WELL PURPOSE:

(home, irrigation, municipal, industrial)

WELL COMPLETION DATA:

- (1) diameter (inches) 10"
- (2) total depth (feet) 93
- (3) static water level (feet) 16 below above top of ground.
- (4) casing Steel, 53' (material), (depth)
10" (size) if telescope see back.
- (5) screen 401, 5' (length), (depth to top)
10" (size), mill steel (material)
- (6) pump 6015, 1000 (HP), (yield gpm)
electric (type power)
- (7) electric log No (yes or no)

(organization running log)

(8) how well bottom plugged plate


DRILLERS REMARKS:

DEPT. OF NATURAL RESOURCES
BUREAU OF LAND & WATER RESOURCES

RECEIVED
SEP 30 1982

If well telescopes please sketch and show depths.

GROUND LEVEL

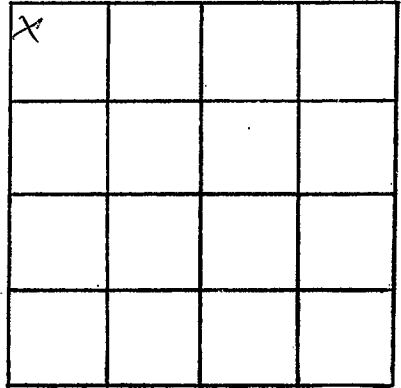

SECTION 1

Please indicate well location X.

ADDITIONAL INFORMATION

If more than one screen,
show locations of each on sketch.