

MISSISSIPPI DEPARTMENT OF NATURAL RESOURCES

Bureau of Land and Water Resources

Southport Mall

P.O. Box 10631

Jackson, Mississippi 39209

WATER WELL DRILLERS LOG

Surflower
N 65
4/22/83

April 22 1983 Larry's well's pump Surflower
 date well completed firm name county well located

LANDOWNER: <u>Red Austers</u>	description of formations encountered	from	to
<u>Indiana ms</u> (mailing address)	<u>slay</u>	<u>0</u>	<u>30</u>
	<u>S sand</u>	<u>30</u>	<u>60</u>
	<u>Sand & gravel</u>	<u>60</u>	<u>140</u>
	<u>slay</u>	<u>140</u>	<u>200</u>
	<u>slay & sand</u>	<u>200</u>	<u>650</u>
	<u>S sand</u>	<u>650</u>	<u>100</u>
	<u>slay</u>	<u>100</u>	<u>1200</u>
	<u>S sand</u>	<u>1200</u>	<u>1260</u>
WELL LOCATION: sec. <u>14</u> T. <u>19</u> R. <u>4</u> E <u>S</u> <u>N</u> <u>W</u> <u>E</u>			
<u>4</u> miles <u>West</u> of <u>Indiana</u> (distance) (direction) (nearest town)			
WELL PURPOSE: <u>Res</u> (home, irrigation, municipal, industrial)			
WELL COMPLETION DATA: <u>1200-41</u>			
(1) diameter (inches) <u>4" x 5"</u>	CODED		
(2) total depth (feet) <u>1260</u>			
(3) static water level (feet) <u>8</u> <u>below</u> <u>above</u> top of ground.			
(4) casing <u>plastic</u> , <u>1220</u> (material) (depth)			
(size) if telescope see back.			
(5) screen <u>10</u> , <u>1220</u> (length) (depth to top)			
(size), <u>plastic</u> (material)			
(6) pump <u>3</u> , <u>60</u> (HP) (yield gpm)			
<u>Electric</u> (type power)			
(7) electric log <u>No</u> (yes or no)			
(organization running log)			
(8) how well bottom plugged <u>Back</u> <u>wash valve</u>			
DRILLERS REMARKS:			


DEPT. OF NATURAL RESOURCES
 BUREAU OF LAND & WATER RESOURCES

JUN - 8 1983

RECEIVED

If well telescopes please sketch and show depths.

GROUND LEVEL

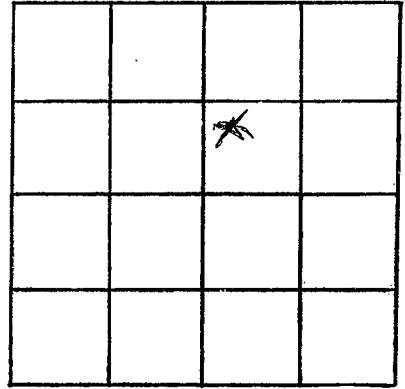

SECTION 14

Please indicate well location X.

ADDITIONAL INFORMATION

If more than one screen,
show locations of each on sketch.