

MISSISSIPPI DEPARTMENT OF NATURAL RESOURCES

Bureau of Land and Water Resources

Southport Mall

P.O. Box 10631

Jackson, Mississippi 39209

WATER WELL DRILLERS LOG

GW 4548

SW/SE, Sec. 7

Elev. 125

N 66
Sunflower Co
3-20-84

CODED

March 20, 1984 Irrigation Equip., Inc. Sunflower
date well completed firm name county well located

LANDOWNER:	description of formations encountered	from	to
Hill Farms	Sand	0	5
Route 2, Box 340	Clay	5	15
Indianola, Ms. 38751	Sand & Clay Mixed	15	20
(mailing address)	Fine Sand	20	65
WELL LOCATION:	Coarse Sand & Gravel	65	105
sec. 7 T 19 N S R 4 E W	Large Gravel	105	
3.5 miles N of Indianola			
(distance) (direction) (nearest town)			
WELL PURPOSE: Irrigation			
(home, irrigation, municipal, industrial)			
WELL COMPLETION DATA:			
(1) diameter (inches) 12"			
(2) total depth (feet) 105'			
(3) static water level (feet) 20' below above top of ground.			
(4) casing Steel 65' (material) (depth)			
(size) If telescope see back.			
(5) screen 40' 65' (length) (depth to top)			
12" Steel (size) (material)			
(6) pump 80 1400 (HP) (yield gpm)			
Deisel (type power)			
(7) electric log (yes or no)			
(organization running log)			
(8) how well bottom plugged Steel plate			

CODED

DEPT. OF NATURAL RESOURCES
BUREAU OF LAND & WATER RESOURCES


MAR 26 1984

RECEIVED

DRILLERS REMARKS:

If well telescopes please sketch and show depths.

GROUND LEVEL

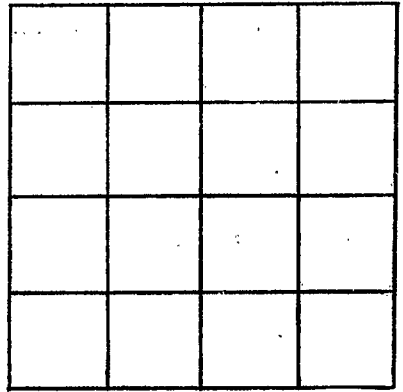

SECTION _____

Please indicate well location X.

ADDITIONAL INFORMATION

If more than one screen,
show locations of each on sketch.