

MISSISSIPPI DEPARTMENT OF NATURAL RESOURCES

Bureau of Land and Water Resources

Southport Mall

P.O. Box 10631

Jackson, Mississippi 39209

CODED

GW 4642

SE/NE, Sec. 23

Elev. 112

WATER WELL DRILLERS LOG

N68
Sunflower
7-18-84

July 18 1984 date well completed
Larry's Well Pump Co firm name
Sunflower county well located

LANDOWNER: De Scroggins
Brid, Ms.
(mailing address)

description of formations encountered	from	to
	clay	0
fine sand	30	50
coarse sand & gravel	50	104

WELL LOCATION:
sec. 23 T 19 N R 4 E
S W
4 miles NE of Indianola
(distance) (direction) (nearest town)

WELL PURPOSE:
(home, irrigation, municipal, industrial)

- WELL COMPLETION DATA:
- (1) diameter (inches) 16"
 - (2) total depth (feet) 104'
 - (3) static water level (feet) 22' ^{below} ~~above~~ top of ground.
 - (4) casing steel (material), 64' (depth)
(size) if telescope see back.
 - (5) screen 40 (length), 64' (depth to top)
16" (size), steel (material)
 - (6) pump 60 (HP), 1200 (yield gpm)
0 (type power)
 - (7) electric log NO (yes or no)
(organization running log)
 - (8) how well bottom plugged steel plate

DRILLERS REMARKS:


DEPT. OF NATURAL RESOURCES
BUREAU OF LAND & WATER RESOURCES

NOV 29 1984

RECEIVED

If well telescopes please sketch and show depths.

GROUND LEVEL

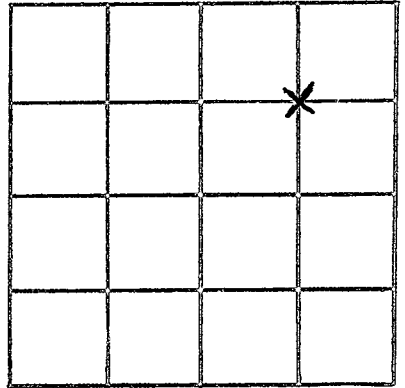

SECTION 23

Please indicate well location X.

ADDITIONAL INFORMATION

If more than one screen,
show locations of each on sketch.