

MISSISSIPPI DEPARTMENT OF NATURAL RESOURCES

Bureau of Land and Water Resources

Southport Mall

P.O. Box 10631

Jackson, Mississippi 39209 CODED

GW 4640

NE/NW, Sec. 23

Elev. 112 WATER WELL DRILLERS LOG

N 69
Sunflower
7-17-84

July 17, 1984 date well completed
Lany's well & pump firm name
Sunflower county well located

LANDOWNER: D. Scroggins

description of formations encountered

from to

Baird, ms.
(mailing address)

slaty	0	30
fine sand	30	50
course sand & gravel	50	108

WELL LOCATION:

sec. 23 T. 19 N R. 4 E
S W
4 miles NE of Indianola
(distance) (direction) (nearest town)

WELL PURPOSE:
(home, irrigation, municipal, industrial)

WELL COMPLETION DATA:

- (1) diameter (inches) 16"
- (2) total depth (feet) 108'
- (3) static water level (feet) 26' ^{below}/_{above} top of ground.
- (4) casing Steel (material), 68' (depth)
(size) if telescope see back.
- (5) screen 40' (length), 68' (depth to top)
16" (size), Steel (material)
- (6) pump 60 (HP), 1200 (yield gpm)
b (type power)
- (7) electric log no (yes or no)

(organization running log)

(8) how well bottom plugged Steel Plate

DRILLERS REMARKS:


DEPT. OF NATURAL RESOURCES
BUREAU OF LAND & WATER RESOURCES

NOV 29 1984

RECEIVED

If well telescopes please sketch and show depths.

GROUND LEVEL

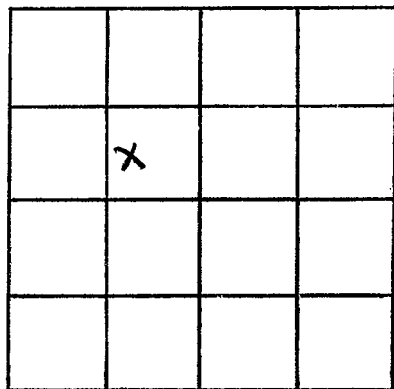

SECTION 23

Please indicate well location X.

ADDITIONAL INFORMATION

If more than one screen,
show locations of each on sketch.