

Bureau of Land and Water Resources

COUNTY WELL LOCATED SUNFLOWER		MISSISSIPPI DEPARTMENT	
WELL NUMBER N 75	CODING CODED	PERMIT NUMBER MS6W 08058	
147B		NAME OF DRILLING FIRM IRRIGATION Equipment	
DATE WELL COMPLETED 3-1-88		INDIANOLA, MS	

P.O. Box 10631

Jackson, Mississippi 39209
WATER WELL DRILLERS LOG

NAME & MAILING ADDRESS OF LANDOWNER

EUREKA

P.O. BOX 87

Indianola, MS

WELL LOCATION: SEC. TOWNSHIP RANGE

27 19 N 4

DISTANCE DIRECTION NEAREST TOWN

3 Miles EAST of Indianola

OTHER LANDMARK

WELL PURPOSE: Home, Irrigation, Municipal, Industrial, Fish Pond, etc.

IRRIGATION

WELL DATA

Well Depth 100'	Casing Diameter (In.) 16	Casing Length (Ft.) 60'
Type of Casing steel	Hole Depth 100'	Depth to Static Water Level 32'
TYPE OF COMPLETION: (Circle One or More): <u>Gravel Packed</u> Underreamed, Telescoped, Natural Development, Open Hole, Other (Describe) _____		
Top of Lap Pipe or Reduction in Casing <div style="display: flex; justify-content: space-between; align-items: center;"> FEET <div style="border: 1px solid black; padding: 5px; text-align: center;"> IF TELESCOPED OR MORE THAN ONE SCREEN: USE BACK PAGE </div> </div>		

SCREEN DATA

Diameter - Inches 16	Length - Feet 40	Slot Size - Inches .060
Screen Type steel		Depth to Bottom - Feet 40

PUMP DATA

PUMP TYPE (Circle One):
Submersible, Turbine, Jet, Flowing Well,
Other (Describe)

POWER TYPE (Circle One):
Electric, Tractor, Diesel, Gasoline, Butane,
Other (Describe)

Pump Capacity (GPM)	No. of Stages	Setting Depth
1250	2	50 FT.

PUMP TEST

Well yielded _____ GPM with
a drawdown of _____ ft.
after _____ hours of pumping

LOG DATA

TYPE OF LOG RUN (Circle One): ☐ No Log Run,
☐ Electric, ☐ Gamma Ray, ☐ Density, ☐ Sonic, ☐ Neutron,
☐ Other (Describe) _____

Name of Organization Running Log

GEOLOGIC DATA (Office Use Only)

Surface Elev.	Geologic Unit	Unit Thickness	Depth to Top
Subs. SWL	Date	Analysis	Aquifer Test


Driller's Remarks

[illegible]

If well telescopes please
sketch and show depths.

GROUND LEVEL

IRRIGATION EQUIPMENT
601/887-2555
INDIANOLA, MS

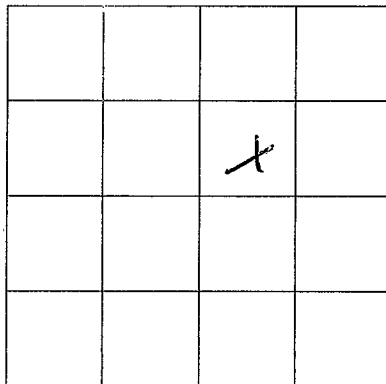

SECTION 27

Please indicate well location X.

ADDITIONAL INFORMATION

If more than one screen,
show location of each on sketch.