

MISSISSIPPI DEPARTMENT OF NATURAL RESOURCES

Bureau of Land and Water Resources

Southport Mall

P.O. Box 10631

Jackson, Mississippi 39209

WATER WELL DRILLERS LOG

CODED

SUNFLOWER
N 80

6-19-86 19 IRRIGATION EQUIPMENT Sun Flower  
 date well completed firm name county well located

LANDOWNER: BRASHIER  
 Planting Company Hwy 82  
 Indianola, MS 38751  
 (mailing address)

description of formations encountered	from	to
clay	0	30
Fine sand	30	55
coarse sand / pea gravel	55	105


WELL LOCATION:  
 sec. 27 T-19 N R-4 E  
 S W  
 3 miles EAST of Indianola  
 (distance) (direction) (nearest town)

WELL PURPOSE: cotton  
 (home, irrigation, municipal, industrial)

WELL COMPLETION DATA:

- (1) diameter (inches) 10"
- (2) total depth (feet) 105
- (3) static water level (feet) 28 below above top of ground.
- (4) casing PVC 65'  
 (material) (depth)  
 10" if telescope see back.  
 (size)
- (5) screen 40' 65'  
 (length) (depth to top)  
 10" PVC  
 (size) (material)
- (6) pump 25 1300  
 (HP) (yield gpm)  
 Electric  
 (type power)
- (7) electric log NO  
 (yes or no)  
 (organization running log)
- (8) how well bottom plugged PVC CAP

CODED

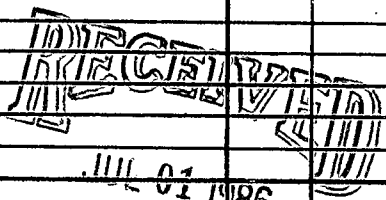

Department of Natural Resources  
 Bureau of Land & Water Resources

DRILLERS REMARKS:  
 # MSG0002155

If well telescopes please sketch and show depths.

IRRIGATION EQUIPMENT  
601/887-2555  
INDIANOLA, MS

GROUND LEVEL

		X	

SECTION 27

Please indicate well location X.

ADDITIONAL INFORMATION

If more than one screen,  
show locations of each on sketch.