

103  
R.L.  
71

CODED

Sunflower  
N 102  
9-26-69

MISSISSIPPI  
BOARD OF WATER COMMISSIONERS  
416 North State Street  
Jackson, Mississippi 39201

WATER WELL DRILLERS LOG

9-26-69  
date well completed

DYER WELL & IRRIGATION SERVICE

Sunflower  
firm name county well located

LANDOWNER: ~~George H. Clark~~  
SUNFLOWER RIVER & REL. LEASE  
INDIANOLA, Miss.  
(mailing address)

description of formations encountered	from	to
Clay	0	13
Cracked sand	13	73
Fine Red Sand	23	33
Coarse sand & gravel	33	43
✓	43	53
✓	53	63
✓	63	73
✓	73	83
✓	83	93
✓	93	103

WELL LOCATION:  
sec 21 T 19 N R 4 E  
2 miles No of Ind  
(distance) (direction) (nearest town)

WELL PURPOSE: IND.  
(home, irrigation, municipal, industrial)

WELL COMPLETION DATA:

(1) diameter (inches) 10"

(2) total depth (feet) 103'

(3) static water level (feet) 15' below above top of ground.

(4) casing BRK IR. 71  
(material) (depth)  
(size) if telescope see back.

(5) screen 32 71  
(length) (depth to top)  
10" BRK IR.  
(size) (material)

(6) pump 10 500  
(HP) (yield gpm)  
ELEC.  
(type power)

(7) electric log No  
(yes or no)  
(organization running log)

(8) how well bottom plugged Plugged


OCT 6 - 1969

DRILLERS REMARKS:

MISS. BD. OF  
WATER COMMISSIONERS

If well telescopes please sketch and show depths.

GROUND LEVEL

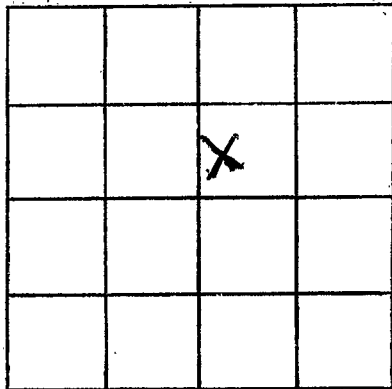

SECTION 21

Please indicate well location X.

ADDITIONAL INFORMATION

If more than one screen, show locations of each on sketch.