

MISSISSIPPI DEPARTMENT OF NATURAL RESOURCES

Bureau of Land and Water Resources

Southport Mall

P.O. Box 10631

Jackson, Mississippi 39209

WATER WELL DRILLERS LOG

CODED

N 104

5-2-83

May 02 1983 Lamm's Well Pump Sunflower
 date well completed firm name county/well located

LANDOWNER: Marion Smith	description of formations encountered	from	to
Indianola ms (mailing address)	clay sand sand & gravel	0 20 56	30 50 100
WELL LOCATION:			
sec. 14 T 19 N R 4 E S W 3 mi. miles North of Indianola (distance) (direction) (nearest town)			
WELL PURPOSE: Fish Pond (home, irrigation, municipal, industrial)			
WELL COMPLETION DATA:			
(1) diameter (inches) 6"			
(2) total depth (feet) 100'			
(3) static water level (feet) 24' below top of ground.			
(4) casing PVC, 60' (material) (depth)			
(size) If telescope see back.			
(5) screen 40', 60' (length) (depth to top)			
6" PVC (size) (material)			
(6) pump 5 300 (HP) (yield gpm)			
Electric (type power)			
(7) electric log No (yes or no)			
(organization running log)			
(8) how well bottom plugged PVC cap			
DRILLERS REMARKS:			

CODED


DEPT. OF NATURAL RESOURCES
 BUREAU OF LAND & WATER RESOURCES

SEP 26 1983

RECEIVED

If well telescopes please sketch and show depths.

GROUND LEVEL

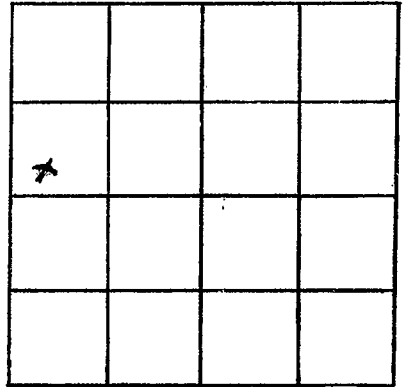

SECTION 14

Please indicate well location X.

ADDITIONAL INFORMATION

If more than one screen, show locations of each on sketch.