

MISSISSIPPI DEPARTMENT OF NATURAL RESOURCES

Bureau of Land and Water Resources

Southport Mall

P.O. Box 10631

Jackson, Mississippi 39209

CODED

GW 4562
SW/ SW, Sec. 8
Elev. 121

WATER WELL DRILLERS LOG

N105
Sunflower
6-11-83

June 11 1983 date well completed
Larry's well & pump firm name
Sunflower county well located

LANDOWNER: Heenan Hill
Indianola, Ms
(mailing address)

description of formations encountered	from	to
slay	0	20
Sand	20	50
Sand & gravel	50	116'

WELL LOCATION:
sec. 8 T. 19 N S R. E W
3 miles North of Indianola
(distance) (direction) (nearest town)

CODED

WELL PURPOSE:
(home, irrigation, municipal, industrial).

WELL COMPLETION DATA:

- (1) diameter (inches) 16"
- (2) total depth (feet) 116'
- (3) static water level (feet) 18 below above top of ground.
- (4) casing Steel, 76'
(material) (depth)
- (size) if telescope see back.
- (5) screen 40', 76'
(length) (depth to top)
- 16", Steel
(size) (material)
- (6) pump 100, 1400
(HP) (yield gpm)
- (type power)
- (7) electric log No
(yes or no)

(organization running log)

- (8) how well bottom plugged Steel Plate

DEPT. OF NATURAL RESOURCES
BUREAU OF LAND & WATER RESOURCES


NOV - 9 1983

DRILLERS REMARKS:

RECEIVED

If well telescopes please sketch and show depths.

GROUND LEVEL

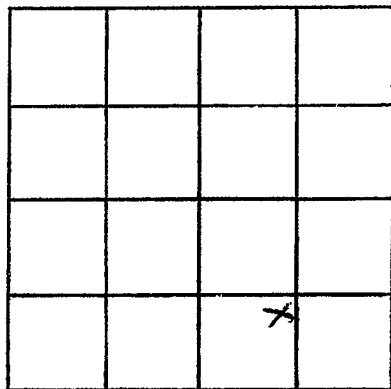

SECTION 8

Please indicate well location X.

ADDITIONAL INFORMATION

If more than one screen, show locations of each on sketch.