

MISSISSIPPI DEPARTMENT OF NATURAL RESOURCES

Bureau of Land and Water Resources

Southport Mall

P.O. Box 10631

Jackson, Mississippi 39209

WATER WELL DRILLERS LOG

CODED

N106
Sunflower
7-106-21-83

June 21, 1983 date well completed
Lanning wells pump firm name
Sunflower county well located

LANDOWNER: Pete Fisher

Sunflower Mo.
(mailing address)

WELL LOCATION:
sec 26 T 20 N R 4 E
S W
3 miles West of Sunflower
(distance) (direction) (nearest town)

description of formations encountered	from	to
clay	0	30
shnd	30	60
Sand + gravel	60	130
clay	130	200
clay & sand	200	450
clay	450	600
shnd	600	660

WELL PURPOSE:
(home, irrigation, municipal, industrial)

WELL COMPLETION DATA: 120-40

(1) diameter (inches) 4" X 2"

(2) total depth (feet) 660'

(3) static water level (feet) 24 ^{below}/_{above} top of ground.

(4) casing plastic, 630
(material) (depth)

(size) if telescope see back.

(5) screen 30, 630
(length) (depth to top)

2", plastic
(size) (material)

(6) pump 1, 20
(HP) (yield gpm)

(type power)

(7) electric log NO
(yes or no)

(organization running log)

(8) how well bottom plugged PVC
cap

DRILLERS REMARKS:


DEPT. OF NATURAL RESOURCES
BUREAU OF LAND & WATER RESOURCES

NOV - 9 1983

RECEIVED

If well telescopes please
sketch and show depths.

GROUND LEVEL

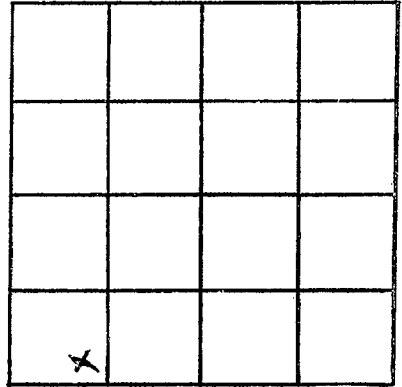

SECTION 26

Please indicate well location X.

ADDITIONAL INFORMATION

If more than one screen, . . .
show locations of each on sketch.