

MISSISSIPPI DEPARTMENT OF NATURAL RESOURCES
 Bureau of Land and Water Resources
 Southport Mall
 P.O. Box 10631
 Jackson, Mississippi 39209
WATER WELL DRILLERS LOG

CODED

SUNFLOWER
N1110

7-2-84 19 1984 Irrigation equipment Sunflower
 date well completed firm name county well located

LANDOWNER: Hill Farms
Hill Hill
Route 2, Box 340
Indianola, Ms. 38951
 (mailing address)

| description of formations encountered | from | to |
|---------------------------------------|-----------|------------|
| <u>Clay</u> | <u>0</u> | <u>31</u> |
| <u>Sand</u> | <u>32</u> | <u>65</u> |
| <u>Sand/gravel</u> | <u>66</u> | <u>110</u> |

WELL LOCATION:
 sec. 7 T. 19 (N) R. 4 E
4 miles North of Indianola
 (distance) (direction) (nearest town)

WELL PURPOSE: Irrigation
 (home, irrigation, municipal, industrial)

- WELL COMPLETION DATA:**
- diameter (inches) 12"
 - total depth (feet) 110
 - static water level (feet) 21 below above top of ground.
 - casing steel 20'
 (material) (depth)
 (size) if telescope see back.
 - screen 40' 20'
 (length) (depth to top)
12" steel
 (size) (material)
 - pump _____ (HP) _____ (yield gpm)
 (type power)
 - electric log _____ (yes or no)
 (organization running log)
 - how well bottom plugged steel plate

DRILLERS REMARKS:

CODED


DEPT. OF NATURAL RESOURCES
 BUREAU OF LAND & WATER RESOURCES

SEP - 4 1984

RECEIVED

If well telescopes please sketch and show depths.

GROUND LEVEL

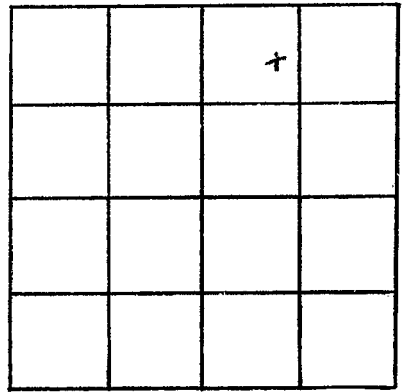

SECTION 7

Please indicate well location X.

ADDITIONAL INFORMATION

If more than one screen,
show locations of each on sketch.