

MISSISSIPPI DEPARTMENT OF NATURAL RESOURCES

Bureau of Land and Water Resources

Southport Mall

P.O. Box 10631

Jackson, Mississippi 39209

WATER WELL DRILLERS LOG

**CODED**

Sunflower  
N 111  
5/16/85

5-16-85

date well completed

IRRIGATION EQUIPMENT

firm name

Sunflower

county well located

LANDOWNER: mark atchley  
707 West Gresham St.  
INDIANOLA, MS 38751  
(mailing address)

description of formations encountered

from to

COURSE SAND	0	40
COURSE SAND / pea GRAVEL	40	80

WELL LOCATION:

sec. 17 T 19 N R 4 E  
4 miles NORTH of INDIANOLA  
(distance) (direction) (nearest town)

**CODED**

WELL PURPOSE: IRRIGATION  
(home, irrigation, municipal, industrial)

WELL COMPLETION DATA:

- (1) diameter (inches) 4"
- (2) total depth (feet) 80
- (3) static water level (feet) 16 below above top of ground.
- (4) casing PVC 60 (material) (depth)
- (size) if telescope see back.
- (5) screen 20' 60' (length) (depth to top)
- 4" PVC (size) (material)
- (6) pump 3 (HP) 80 (yield gpm)
- Electric (type power)
- (7) electric log NO (yes or no)
- (organization running log)
- (8) how well bottom plugged PVC CAP

**RECEIVED**  
JUN 5 1985


Department of Natural Resources  
Bureau of Land & Water Resources

DRILLERS REMARKS:

If well telescopes please sketch and show depths.

IRRIGATION EQUIPMENT  
601/887-2555  
INDIANOLA, MS

GROUND LEVEL

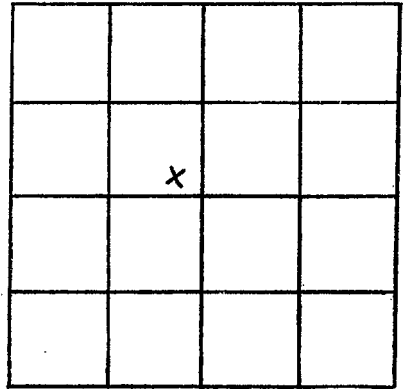

SECTION 17

Please indicate well location X.

ADDITIONAL INFORMATION

If more than one screen,  
show locations of each on sketch.