County: Sunflower 133 Permit: 39809 Irrigation Equipment Driller: 2-23-05	Mississippi Department of Environmental Quality Office of Land and Water Resources P.O. Box 10631		For Office Use Only: Aquifer:	
State Law requires that this repo 30 days of completion of drilling Well Owner Informa	of the well.		vith the Department within	
Owner Name City Of Indianola		Latitude: 33 .27 , 07	7N Longitude: 90 38 05W	
Mailing Address: Box 269		Method of Lat/Long (circle one): Conventional Survey,		
	•	NE 1/SW 1/4 Sec_32 Distance Direction	1 GPS, Survey-grade GPS Twn19NRng4W Nearest Townof	
	Well	l Data		
Purpose of Well (circle one) Home Ind Date well drilling started: 2-23 If flowing, method of flow regulation: Val	3-05 Date	well drilling completed:2-	-23-05	

24ft. feet above or below (circle one) land surface

Bentonite)

Gravel packed

Other (describe):

Logs run (circle all applicable): No log run Electric Gamma Ray Density Sonic Neutron Other:

Department of Environmental Quality and/or the Mississippi Department of Health regulations and state laws. Irrigation Equipment Inc.

128'

16

Setting depth: From

electric tape

Mix

(steel tape

Casing diameter:

Screen diameter:

Well depth:

Cement

inches

0695

feet

feet

Date measured:

Sch.40 PVC

Sch.40 PVC

feet

Natural Development

128

Signature of Water Well Contractor

Open hole

_feet. If telescoped or more than one screen, describe on back of page

Well grouted to a depth of _____10

Type of casing:

Type of screen:

feet to

Telescoped

air line

inches

inches

Underreamed

I certify that the well was drilled, constructed, and completed in accordance with all applicable requirements of the Mississippi

79

Static Water Level:

Type of grout (circle one):

Hole depth:

Casing length:

Screen length:

Screen slot size:

Method of Measurement (circle one)

128'

78

40

Type of completion (circle all applicable):

Top of lap pipe or reduction in casing:

Name of organization running log(s):

Patrick M. Chism

.050

Print Name of Water Well Contractor and License No.

RECEIVED


MAR 0 4 2005

BY: OLWR

If more than one screen, show location of each on sketch

Sketch the property layout and include the following: 1) the well location; 2) any permanent structures on the property that may aid in locating the well; 3) any roads, power lines, or other items that may aid in locating the property and the well; 4) indicate direction.					
				• .	
·			•		
		. •			
Landowner Name:					

Signature of Water Well Contractor

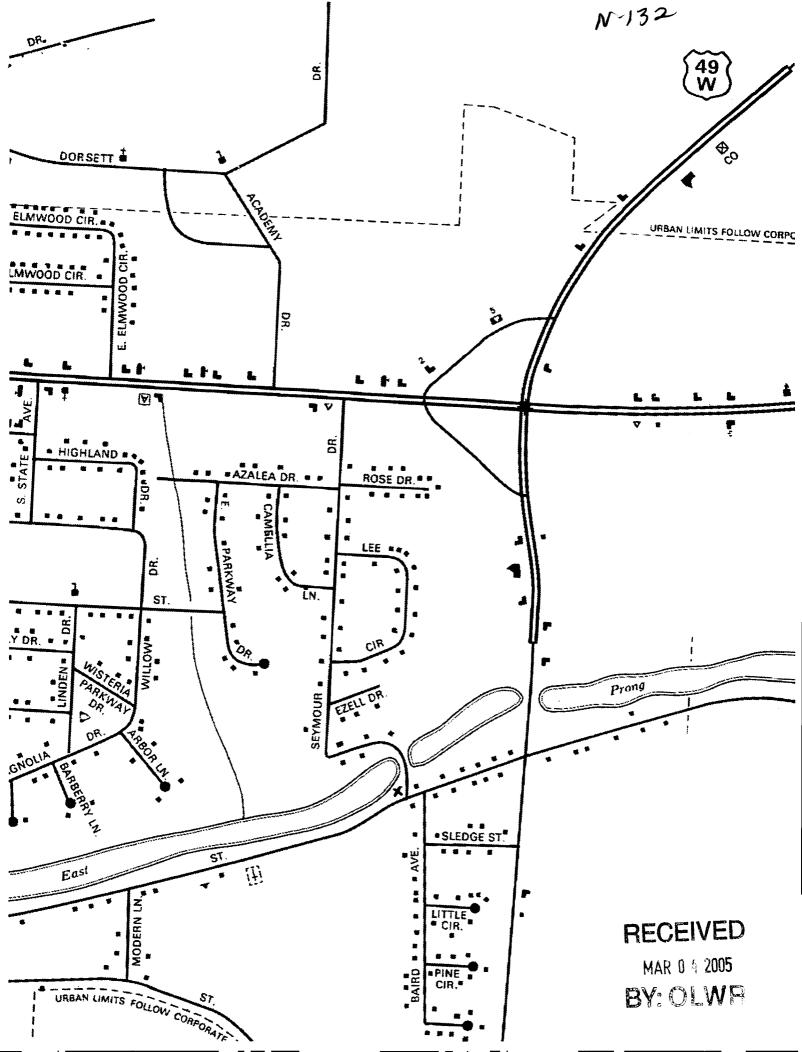

STATE WELL REPORT

Part 2

Sunflower Pump Installer's Completion Report Mississippi Department of Environmental Quality
Office of Land and Water Resources Permit #6w - 39809 Irrigation Equipment P.O. Box 10631 Jackson, MS 39289-0631

For Office Use Only: Aquifer:

County:

Driller:

Date completed:		961-5210 4-6938 (fax)			
This report should be prepared by the pump installer in detail and filed with the Department within 30 days of the installation of pump.					
Well Owner Informat	ion	Well Location			
Owner Name: City Of Indianola		Latitude:Longitude:			
Mailing Address: Box 269		Method of Lat/Long (circle one): Conventional Survey,			
Indianola, MS 38751 City State Zip Code		USGS quad, Hand-held GPS, Survey-grade GPS			
		NE 1/4 SW 1/4 Sec 32 Twn 19N Rng 4W			
·		Distance Direction			
Telephone No. ()		Milesof			
Pum p Type Circle one		Power Type Circle one			
Air Lift Jet	Submersible	Diesel Engine Gasoline	Engine Natural Gas		
Bucket Piston	Turbine	Electric Motor Hand	Tractor PTO		
Centrifugal Rotary	Flowing Well	·	specify):		
Other (specify):		Horse Power Rating of Motor: 60			
Date Pump Installed: 2-24-05		Setting Depth:	70 feet		
Rated Pump Capacity: 2500	Gallons Per Minute	Number of Stages:	1		
Pump Test Data			suring Water Level role one		
Date Well Tested:		Air Line Electric Meas	uring Line Steel Tape		
Static Water Level (A):Feet Below Land Surface		Other (specify):			
Pumping Water Level (B):Feet	Below Land Surface				
Drawdown [(B) - (A)]:Feet Below Land Surface		For flowing well, measured shut in head:feet			
Test Pumping Rate:Gallons Per Minute		Well yieldedGPM with a drawdown of			
Duration of Pump Test (minimum 4 hours):hours		feet afterhours of pumping			
I HEREBY CERTIFY that the above statements are true to the best of my knowledge. Patrick M. Chism 0695 Print Name of Pump Installer and License No. (if applicable) Signature of Pump Installer					

RECEIVED

MAR 0 4 2005