Coverty: Sunflower Prime Permit #: Coverty: Mississippi Department Irrigation Equipment Office of Land a Driller: Provident Provident Date drilling completed: 4-22-05 (601)	ell Report art 1 of Environmental Quality nd Water Resources ox 10631 S 39289-0631 >61-5210 -6938 (fax) driller in detail and filed with the Department within		
Well Owner Information	Well Location		
Henri Watson Estate OwnerNameC/OJimmy_Steward	Latitude:' Longitude:''		
Mailing Address: 3 Steward Road	Method of Lat/Long (circle one): Conventional Survey,		
	USGS quad, Hand-held GPS, Survey-grade GPS		
Sunflower, MS38778CityStateZip Code662-569-3412	NW 14 SE 14 Sec_13 Twn 19N Rng 4W Distance Direction Nearest Town 3 Miles South of Sunflower		
Well I	ata		
Purpose of Well (circle one) Home Industrial Public Supply rigation Fish Culture Other:			
Casing length: 82 feet Casing diameter. 16	_inches Type of casing:PVC_Sch.40		
Screen length: <u>40</u> feet Screen diameter: <u>16</u>			
Screen slot size: <u>.050</u> inches Setting depth: From			
Type of completion (circle all applicable): Gravel packed Underreamed Telescoped Open hole Natural Development Other (describe):			
Top of lap pipe or reduction in casing:feet. If telescoped or more than one screen, describe on back of page			
Logs run (circle all applicable); No log run Electric Gamma Ray Density Sonic Neutron Other:			
Name of organization running log(s):			
I certify that the well was drilled, constructed, and completed in accordance with all applicable requirements of the Mississippi			
Department of Environmental Quality and/or the Mississippi Dep	artment of Health regulations and state laws.		
Irrigation Equipment Inc. Patrick M. Chism 0695	Patrik M Chin		

MAY 1 2 2005 BY: OLWR If well telescopes please sketch below and show depths.


Ground Level

• •

N	13	4	
	~ ~		

Description of Formations Encountered	From	To
	0	25
<u>Clay</u> Fine Sand	26	35
Med. Sand	36	55
<u>Med.Sand</u> Coarse Sand/gravel	56	122
		<u> </u>
		<u> </u>
	_	
· · · · · · · · · · · · · · · · · · ·		┦──┥
		╀──┤
		-
		┼──┥
······		
		+
		+
		+

If more than one screen, show location of each on sketch

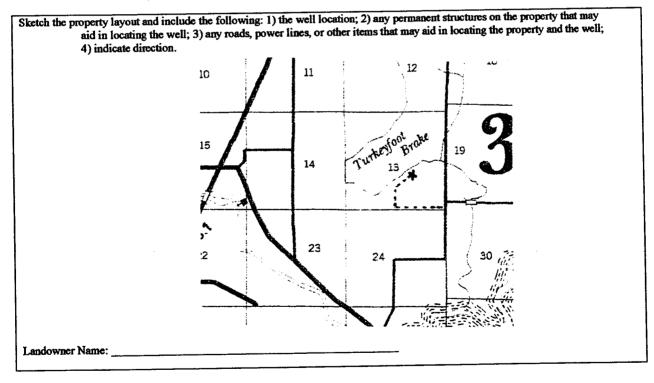

Signature of Water Well Contractor

sunf	Elower	רייים דיי <u>י</u> ן	ELL REPORT Part 2	For Office Use Only:
Permit SW Irrigatic Driller: Date completed:		Mississippi Departme Office of Land P.O. Jackson,	Pump Installer's Completion Report Mississippi Department of Environmental Quality Office of Land and Water Resources P.O. Box 10631 Jackson, MS 39289-0631 (601)961-5210	
		(601)3	Elevation:	
This report s installation o	f pump.		tail and filed with the Departme	
	Well Owner Informenti Watson	Estate		I Location
Owner Name: <u>C</u> /	o Jimmy St	eward	Latitude:	_Longitude:
Mailing Address:_	3 Steward	Road	Method of Lat/Long (circle or	ne): Conventional Survey,
-			USGS quad, Hand	I-held GPS, Survey-grade GPS
-		<u>, MS 387</u> 78 te Zip Code	<u>NW</u> 1/4 <u>SE</u> 1/4 <u>Sec</u> 1	3 Twn 19N Rng 4W
		-	Distance Direction	Nearest Town
6 6 Telephone No. (52-569-3412		<u>3</u> <u>Miles</u> <u>South</u> o	f_Sunflower
	Pum p Type Circle one			wer Type ircle one
Air Lift	Jet	Submersible	Diesel Engine Gasolin	ne Engine Natural Gas
Bucket	Piston	Turbine	Electric Motor Hand	Tractor PTO
Centrifugal	Rotary	Flowing Well	Windmill Other	(specify):
Other (specify): _				. 60
Date Pump Installe	ed:4-23-	05	Setting Depth:7	0 feet
Rated Pump Capa	2500-300 city:	OGallons Per Minute	Number of Stages:1	
	Pump Test Da	ita		easuring Water Level
Date Well Tested:			Air Line Electric Mea	
Static Water Level	l (A):I	Feet Below Land Surface	Other (specify):	
Pumping Water Lo	evel (B):F	eet Below Land Surface		
	(A)]:F	eet Below Land Surface	For flowing well, measured sl	
		Test Pumping Rate:Gallons Per Minute		
	e:	Gallons Per Minute	Well yielded	GPM with a drawdown of

I HEREBY CERTIFY that the above statements are true to the best of Patrick M. Chism 0695	of my/knowledge
Patrick M. Chism 0695	Patriets NI Chian
Print Name of Pump Installer and License No. (if applicable)	Signature of Pump Installer

RECEIVED MAY 1 2 2005 BY: OLWR