
	- State W	/ell Report	D. Off. M. O.L.
C		Part 1	For Office Use Only:
County: Sunflower	Part 1 Mississippi Department of Environmental Quality		Aquifer:
Permit # 16W 40381	Office of Land and Water Resources		well #: N - 138
Irrigation Equipment			
Driller:	Jackson, N	AS 39289-0631	L. S. Elevation:
Date drilling completed: $10 - 17 - 05$	(601))961-5210	E-log #:
	(601)35	54-6938 (fax)	E-10g #
State Law requires that this rej	port be prepared by the	e driller in detail and filed w	vith the Department within
30 days of completion of drillin Well Owner Inform	astion	We	1 Location
Dwner Name_Jubilee Fish		Latitude: 33, 30, 20	N Longitude: 90 •34 • 64
Mailing Address: 1301 Bayou	Drive	Method of Lat/Long (circle o	
		AUSGS quad, Hand-held	
		27W 1/4 NE 1/4 Sec 1/4	4
Indianola, 1		Distance Direction	Nearest Town
	tate Zip Code		of Indianola
662-887-40 Telephone No. ()	53		
•		Data	
Purpose of Well (circle one) Home In Date well drilling started: $10-17$. If flowing, method of flow regulation: V Static Water Level: 41 feet	-05 Date	well drilling completed:1	
Stotio Water Level: 3 / Teet	shove of below (circle one)) land surface Date measured	10-18-05
Method of Measurement (circle one)	steel take electric tap	e air line other:	
Method of Measurement (circle one)	steel take electric tap	e air line other:	
Method of Measurement (circle one) Hole depth: <u>136</u> Well of	steel take electric tap depth: <u>136</u>	e air line other: Well grouted to a depth of	
Method of Measurement (circle one) Hole depth: <u>136</u> Well of Type of grout (circle one): Cement	etect take electric tap depth: 136 Bentonize Mis	e air line other: Well grouted to a depth of x	<u>10</u> feet
Method of Measurement (circle one) Hole depth: <u>136</u> Well of Type of grout (circle one): Cement Casing length: <u>96</u> feet Ca	depth: <u>136</u> Bentonite Minasing diameter: <u>16</u>	e air line other: _ Well grouted to a depth of x inches Type of casing:	<u> 10 feet</u> PVC Sch.40
Method of Measurement (circle one) Hole depth: <u>136</u> Well of Type of grout (circle one): Cement Casing length: <u>96</u> feet Ca	depth: <u>136</u> Bentonite Minasing diameter: <u>16</u>	e air line other: _ Well grouted to a depth of x inches Type of casing:	<u> 10 feet</u> PVC Sch.40
Method of Measurement (circle one) Hole depth: <u>136</u> Well of Type of grout (circle one): Cement Casing length: <u>96</u> feet Ca Screen length: <u>40</u> feet So	depth: <u>136</u> Bentonite Misasing diameter: <u>16</u>	e air line other: _ Well grouted to a depth of x inches Type of casing: inches Type of screen:	<u>10</u> feet PVC Sch. 40 PVC Sch. 40
Method of Measurement (circle one) Hole depth: <u>136</u> Well of Type of grout (circle one): Cement Casing length: <u>96</u> feet Ca Screen length: <u>40</u> feet So	depth: 136 Bentonite Mi: asing diameter: 16	we air line other: Well grouted to a depth of x inches Type of casing: inches Type of screen:	<u>10</u> feet PVC Sch.40 PVC Sch.40
Method of Measurement (circle one) Hole depth: <u>136</u> Well of Type of grout (circle one): Cement Casing length: <u>96</u> feet Ca Screen length: <u>40</u> feet So	etect take electric tap depth: <u>136</u> Bentonite Mi: asing diameter: <u>16</u> creen diameter: <u>16</u> s Setting depth: From e): Gravel packed Und	e air line other: Well grouted to a depth of x inches Type of casing: inches Type of screen: feet to kerreamed Telescoped Op	<u>10</u> feet <u>PVC Sch. 40</u> <u>PVC Sch. 40</u> <u>136</u> feet en hole Natural Development
Method of Measurement (circle one) Hole depth: <u>136</u> Well of Type of grout (circle one): Cement Casing length: <u>96</u> feet Ca Screen length: <u>40</u> feet So Screen slot size: <u>050</u> inches	etect take electric tap depth: <u>136</u> Bentonite Mi: asing diameter: <u>16</u> creen diameter: <u>16</u> s Setting depth: From e): Gravel packed Und	e air line other: _ Well grouted to a depth of x inches Type of casing: inches Type of screen: 97feet to	<u>10</u> feet <u>PVC Sch. 40</u> <u>PVC Sch. 40</u> <u>136</u> feet en hole Natural Development
Method of Measurement (circle one) Hole depth: <u>136</u> Well of Type of grout (circle one): Cement Casing length: <u>96</u> feet Ca Screen length: <u>40</u> feet So Screen slot size: <u>050</u> inches Type of completion (circle all applicable	etect take electric tap depth: 136 Bentonite Mi: asing diameter: 16 creen diameter: 16 s Setting depth: From e): Gravel packed Und Other (describe):	e air line other: _ Well grouted to a depth of x inches Type of casing: inches Type of screen: 97feet to kerreamed Telescoped Op	<u>10</u> feet <u>PVC Sch. 40</u> <u>PVC Sch. 40</u> <u>136</u> feet en hole Natural Development
Method of Measurement (circle one) Hole depth: <u>136</u> Well of Type of grout (circle one): Cement Casing length: <u>96</u> feet Ca Screen length: <u>40</u> feet So Screen slot size: <u>050</u> inches Type of completion (circle all applicable Top of lap pipe or reduction in casing:	steel take electric tap depth: 136 Bentonite Min asing diameter: 16 creen diameter: 16 s Setting depth: From e): Gravel packed Und Other (describe): feet. If	e air line other: Well grouted to a depth of x inches Type of casing: inches Type of screen: 97feet to lerreamed Telescoped Op telescoped or more than one s	<u>10</u> feet <u>PVC Sch. 40</u> <u>PVC Sch. 40</u> <u>136</u> feet en hole Natural Development creen, describe on back of page
Method of Measurement (circle one) Hole depth: <u>136</u> Well of Type of grout (circle one): Cement Casing length: <u>96</u> feet Ca Screen length: <u>40</u> feet So Screen slot size: <u>050</u> inches Type of completion (circle all applicable	steel take electric tap depth: 136 Bentonite Min asing diameter: 16 creen diameter: 16 s Setting depth: From e): Gravel packed Und Other (describe): feet. If	e air line other: Well grouted to a depth of x inches Type of casing: inches Type of screen: 97feet to lerreamed Telescoped Op telescoped or more than one s	<u>10</u> feet <u>PVC Sch. 40</u> <u>PVC Sch. 40</u> <u>136</u> feet en hole Natural Development creen, describe on back of page
Method of Measurement (circle one) Hole depth: <u>136</u> Well of Type of grout (circle one): Cement Casing length: <u>96</u> feet Ca Screen length: <u>40</u> feet So Screen slot size: <u>050</u> inches Type of completion (circle all applicable) Top of lap pipe or reduction in casing: Logs run (circle all applicable): No log	etect take electric tap depth: 136 Bentonite Min asing diameter: 16 creen diameter: 16 s Setting depth: From e): Gravel packed Und Other (describe): feet. If un Electric Gamma Ra	e air line other: Well grouted to a depth of x inches Type of casing: inches Type of screen: feet to kerreamed Telescoped Op telescoped or more than one s ay Density Sonic Neutron	<u>10</u> feet <u>PVC Sch. 40</u> <u>PVC Sch. 40</u> <u>136</u> feet en hole Natural Development creen, describe on back of page Other:
Method of Measurement (circle one) Hole depth: <u>136</u> Well of Type of grout (circle one): Cement Casing length: <u>96</u> feet Ca Screen length: <u>40</u> feet So Screen slot size: <u>050</u> inches Type of completion (circle all applicable) Top of lap pipe or reduction in casing: Logs run (circle all applicable): No log	etect take electric tap depth: 136 Bentonite Min asing diameter: 16 creen diameter: 16 s Setting depth: From e): Gravel packed Und Other (describe): feet. If un Electric Gamma Ra	e air line other: Well grouted to a depth of x inches Type of casing: inches Type of screen: feet to kerreamed Telescoped Op telescoped or more than one s ay Density Sonic Neutron	<u>10</u> feet <u>PVC Sch. 40</u> <u>PVC Sch. 40</u> <u>136</u> feet en hole Natural Development creen, describe on back of page Other:
Method of Measurement (circle one) Hole depth: <u>136</u> Well of Type of grout (circle one): Cement Casing length: <u>96</u> feet Ca Screen length: <u>40</u> feet So Screen slot size: <u>050</u> inches Type of completion (circle all applicable) Top of lap pipe or reduction in casing: Logs run (circle all applicable): No log Name of organization running log(s): I certify that the well was drilled, com	estructed, and completed is	e air line other: Well grouted to a depth of x inches Type of casing: inches Type of screen: feet to lerreamed Telescoped Op telescoped or more than one s ay Density Sonic Neutron n accordance with all applicat	<u>10</u> feet <u>PVC_Sch_40</u> <u>PVC_Sch_40</u> <u>136</u> feet en hole Natural Development creen, describe on back of page Other:
Method of Measurement (circle one) Hole depth: <u>136</u> Well of Type of grout (circle one): Cement Casing length: <u>96</u> feet Ca Screen length: <u>40</u> feet So Screen slot size: <u>050</u> inches Type of completion (circle all applicable) Top of lap pipe or reduction in casing: Logs run (circle all applicable): No log Name of organization running log(s): I certify that the well was drilled, com	steel take electric tap depth: 136 Bentonite Min asing diameter: 16 creen diameter: 16 s Setting depth: From e): Gravel packed Und Other (describe): feet. If un Electric Gamma Ra- structed, and completed in ty and/or the Mississippi I	e air line other: Well grouted to a depth of x inches Type of casing: inches Type of screen: feet to lerreamed Telescoped Op telescoped or more than one s ay Density Sonic Neutron n accordance with all applicat	<u>10</u> feet <u>PVC_Sch_40</u> <u>PVC_Sch_40</u> <u>136</u> feet en hole Natural Development creen, describe on back of page Other:
Method of Measurement (circle one) Hole depth: <u>136</u> Well of Type of grout (circle one): Cement Casing length: <u>96</u> feet Ca Screen length: <u>40</u> feet So Screen slot size: <u>050</u> inches Type of completion (circle all applicable) Top of lap pipe or reduction in casing: Logs run (circle all applicable): No log Name of organization running log(s): I certify that the well was drilled, com	steel take electric tap depth: 136 Bentonite Min asing diameter: 16 creen diameter: 16 s Setting depth: From e): Gravel packed Und Other (describe): feet. If feet. If un Electric Gamma Ra- istructed, and completed i ty and/or the Mississippi I oment Inc.	e air line other: Well grouted to a depth of x inches Type of casing: inches Type of screen: feet to lerreamed Telescoped Op telescoped or more than one s ay Density Sonic Neutron n accordance with all applicat	<u>10</u> feet <u>PVC_Sch_40</u> <u>PVC_Sch_40</u> <u>136</u> feet en hole Natural Development creen, describe on back of page Other:

NOV 0 1 2005 BY: OLWR If well telescopes please sketch below and show depths.

Ground Level

Description of Formations Encountered	From	To
Clav		34
Fine Sand/gravel Med. Sand/gravel	35	47
Med Sand/gravel	48	136
neu. bunu/gruter		
	<u> </u>	+
		1-1
		+ - 1
		++
		╄──┥
		+ -
		+1
		+
		+
		4

If more than one screen, show location of each on sketch

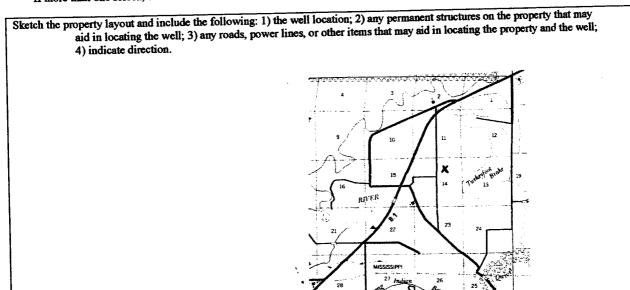

Landowner Name:

Signature of Water Well Contractor

STATE WELL REPORT		
County: Sunflower	Part 2 Pump Installer's Completion Report Mississippi Department of Environmental Quality	For Office Use Only: Aquifer:
Permit #: <u>60040381</u> Irrigation Equipment Date completed: <u>10-18-05</u>	Office of Land and Water Resources	Well #: $N - 13.5$ Elevation:

÷

This report should be prepared by the pump installer in detail and filed with the Department within 30 days of the installation of pump.

Well Owner Information	Well Location		
Owner Name:Jubilee Fish Farm	Latitude:Longitude:		
Mailing Address: 1301 Bayou Drive	Method of Lat/Long (circle one): Conventional Survey,		
	USGS quad, Hand-held GPS, Survey-grade GPS		
<u>Indianola, MS 387</u> 51 City State Zip Code	<u>SW 1/4 NE 1/4 Sec 14</u> Twn 19N _{Rng} 4W		
	Distance Direction Nearest Town		
662-887-4053 Telephone No. ()	4 <u>Miles NE of</u> Indianola		

	Pump Ty Circle on			Power Type Circle one	
Air Lift	Jet	Submersible	Diesel Engine	Gasoline Engine	Natural Gas
Bucket	Piston	Turbin	Electric Motor	Hand	Tractor PTO
Centrifugal	Rotary	Flowing Well	Windmill	Other (specify):	
Other (specify):		·····	Horse Power Ratin	g of Motor: 60)
Date Pump Installed:	10-18-0	5	Setting Depth:	70	feet
Rated Pump Capacity	,:2500-3	000 Gallons Per Minute	Number of Stages:	1	

Pump Test Data	Method of Measuring Water Level Circle one		
Date Well Tested:			
Static Water Level (A):Feet Below Land Surface	Air Line Electric Measuring Line Steel Tape		
Pumping Water Level (B):Feet Below Land Surface	Other (specify):		
Drawdown [(B) – (A)]:Feet Below Land Surface	For flowing well, measured shut in head:feet		
Test Pumping Rate:Gallons Per Minute	Well yieldedGPM with a drawdown of		
Duration of Pump Test (minimum 4 hours):hours	feet afterhours of pumping		

I HEREBY CERTIFY that the above statements an	e true to the best of my knowledge.
Patrick M. Chism 0695	Kaha Michi
Print Name of Pump Installer and License No. (if a	pplicable) Signature of Pump Installer

NOV 0 1 2005 BY: OLWR