

State Well Report

Part 1

Mississippi Department of Environmental Quality
Office of Land and Water Resources
P.O. Box 10631
Jackson, MS 39289-0631
(601)961-5210
(601)354-6938 (fax)

For Office Use Only:

Aquifer: _____
Well #: N-140
L. S. Elevation: _____
E-log #: _____

County: Sunflower
Permit #: 601 41116
Irrigation Equipment
Driller: _____
Date drilling completed: 5-31-06

State Law requires that this report be prepared by the driller in detail and filed with the Department within 30 days of completion of drilling of the well.

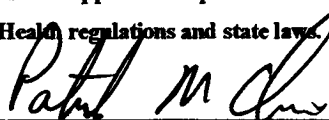
Well Owner Information	Well Location
Owner Name: <u>Baird Planting Company</u>	Latitude: <u>33.2937.1</u> , Longitude: <u>90.3748.4</u>
Mailing Address: <u>54 Round Lake Road</u>	Method of Lat/Long (circle one): Conventional Survey, USGS quad, Hand-held GPS, Survey-grade GPS
<u>Indianola MS 38751</u>	<u>SE 1/4 SE 1/4 Sec 17 Twn 19N Rng 4W</u>
City State Zip Code	Distance Direction Nearest Town
<u>662-887-5927</u>	<u>3 Miles North of Indianola</u>
Telephone No. ()	

Well Data

Purpose of Well (circle one) Home Industrial Public Supply Irrigation Fish Culture Other: _____
Date well drilling started: 5-31-06 Date well drilling completed: 5-31-06
If flowing, method of flow regulation: Valve _____ Other (describe) _____
Static Water Level: 23' feet above or below (circle one) land surface Date measured: 6-1-06
Method of Measurement (circle one) steel tape electric tape air line other: _____
Hole depth: 125 Well depth: 125 Well grouted to a depth of 10 feet
Type of grout (circle one): Cement Bentonite Mix
Casing length: 85 feet Casing diameter: 10 inches Type of casing: PVC
Screen length: 40 feet Screen diameter: 10 inches Type of screen: PVC
Screen slot size: .050 inches Setting depth: From 86 feet to 125 feet
Type of completion (circle all applicable): Gravel packed Underreamed Telescoped Open hole Natural Development
Other (describe): _____
Top of lap pipe or reduction in casing: _____ feet. If telescoped or more than one screen, describe on back of page
Logs run (circle all applicable): No log run Electric Gamma Ray Density Sonic Neutron Other: _____
Name of organization running log(s): _____

I certify that the well was drilled, constructed, and completed in accordance with all applicable requirements of the Mississippi Department of Environmental Quality and/or the Mississippi Department of Health regulations and state laws.

Irrigation Equipment Inc.
Patrick M. Chism 0695


Signature of Water Well Contractor

Print Name of Water Well Contractor and License No.

RECEIVED
JUN 15 2006
BY: OLWR

STATE WELL REPORT

Part 2

Pump Installer's Completion Report
 Mississippi Department of Environmental Quality
 Office of Land and Water Resources
 P.O. Box 10631
 Jackson, MS 39289-0631
 (601)961-5210
 (601)354-6938 (fax)

County: sunflower
 Permit #: 00441116
 Irrigation Equipment
 Driller: _____
 Date completed: 5-31-06
Copy information from block on Part 1

For Office Use Only:

Aquifer: _____
 Well #: N-140
 Elevation: _____

This part of the report must be completed by a licensed water well contractor or a licensed pump installer. A copy of Part 1 of the report must be attached and both parts filed with the Department at the above address within 30 days of well completion.

Well Owner Information	Well Location
Owner Name: <u>Baird Planting Company</u>	Latitude: _____ Longitude: _____
Mailing Address: <u>54 Round Lake Road</u>	Method of Lat/Long (check one): Conventional Survey <input type="checkbox"/> , USGS quad _____, Hand-held GPS <input type="checkbox"/> , Survey-grade GPS <input type="checkbox"/>
<u>Indianola</u> MS <u>38751</u>	SE <input type="checkbox"/> $\frac{1}{4}$ SE <input type="checkbox"/> $\frac{1}{4}$ Sec <u>17</u> T <u>19</u> N R <u>4</u> W
City State Zip Code	Distance Direction Nearest Town
Telephone No. () <u>662-887-5927</u>	<u>3</u> Miles <u>North</u> of <u>Indianola</u>

Pump Type Circle one	Power Type Circle one
Air Lift Jet <input type="checkbox"/> Submersible <input checked="" type="checkbox"/>	Diesel Engine <input type="checkbox"/> Gasoline Engine <input type="checkbox"/> Natural Gas <input type="checkbox"/>
Bucket Piston <input type="checkbox"/> Turbine <input type="checkbox"/>	Electric Motor <input checked="" type="checkbox"/> Hand <input type="checkbox"/> Tractor PTO <input type="checkbox"/>
Centrifugal Rotary <input type="checkbox"/> Flowing Well <input type="checkbox"/>	Windmill <input type="checkbox"/> Other (specify): _____
Other (specify): _____	Horse Power Rating of Motor: <u>15</u>
Date Pump Installed: <u>6-1-06</u>	Setting Depth: <u>70</u> feet
Rated Pump Capacity: <u>750</u> Gallons Per Minute	Number of Stages: <u>1</u>

Pump Test Data	Method of Measuring Water Level Circle one
Date Well Tested: _____	Air Line <input type="checkbox"/> Electric Measuring Line <input type="checkbox"/> Steel Tape <input type="checkbox"/>
Static Water Level (A): _____ Feet Below Land Surface	Other (specify): _____
Pumping Water Level (B): _____ Feet Below Land Surface	For flowing well, measured shut in head: _____ feet
Drawdown [(B) - (A)]: _____ Feet Below Land Surface	Well yielded _____ GPM with a drawdown of _____ feet after _____ hours of pumping
Test Pumping Rate: _____ Gallons Per Minute	
Duration of Pump Test (minimum 4 hours): _____ hours	

I HEREBY CERTIFY that the above statements are true to the best of my knowledge

Patrick M. Chism 0695
 Print Name of Pump Installer and License No. (if applicable) Patrick M. Chism
Signature of Pump Installer

Form: OLMBSYR
RECEIVED
 JUN 15 2006
 BY: OLWR