

SUNFLOWER
 N 2000
 4/5/78

MISSISSIPPI
 BOARD OF WATER COMMISSIONERS
 416 North State Street
 Jackson, Mississippi 39201

WATER WELL DRILLERS LOG

4-5 1978 Bailey Drlg Co. Sunflower
 date well completed firm name county well located

LANDOWNER: Rodgers Brashier
 Indianola, Miss.
 (mailing address)

description of formations encountered	from to	
Clay	0	15
Sand	15	80
Gravel	80	94

WELL LOCATION:
 sec. 35 T 9 N R 4 E
 3 1/2 miles East of Indianola
 (distance) (direction) (nearest town)

WELL PURPOSE: Lake
 (home, irrigation, municipal, industrial)

- WELL COMPLETION DATA:
- (1) diameter (inches) 4"
 - (2) total depth (feet) 94
 - (3) static water level (feet) 23 below top of ground.
 - (4) casing steel 84 (material) (depth)
 4" (size) if telescope see back.
 - (5) screen 10 84 (length) (depth to top)
 4" Stainless Steel (size) (material)
 - (6) pump 1 1/2 35 (HP) (yield gpm)
 Electric (type power)
 - (7) electric log no (yes or no)
- (organization running log)


(8) how well bottom plugged
 back measure valve

DRILLERS REMARKS:

REGISTERED
 APR 7 1978
 MISS. DD. OF WATER CONTROL

If well telescopes please
sketch and show depths.

GROUND LEVEL

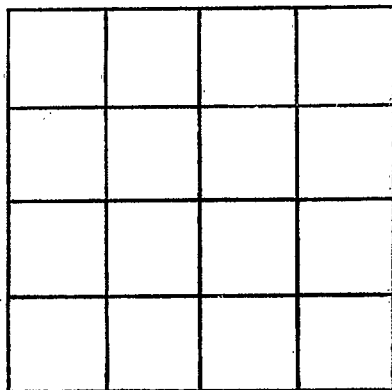

SECTION _____

Please indicate well location X.

ADDITIONAL INFORMATION

If more than one screen,
show locations of each on sketch.