

MISSISSIPPI DEPARTMENT OF NATURAL RESOURCES

Bureau of Land and Water Resources

Southport Mall

P.O. Box 10631

Jackson, Mississippi 39209

WATER WELL DRILLERS LOG

Sunflower
N
2002

15 Nov 1988 date well completed Lambert Drilling firm name Scott county well located

LANDOWNER:	description of formations encountered	from	to
Troy Wilbarr Indianola, M.S. (mailing address)			
WELL LOCATION:	Sand	30	70
sec. <u>36</u> T <u>19</u> N R <u>4</u> E <u>4</u> miles <u>E</u> of <u>Indianola</u> (distance) (direction) (nearest town)	fine gravel	70	150
WELL PURPOSE: <u>home</u> (home, irrigation, municipal, industrial)	sand gravel	150	210
WELL COMPLETION DATA:	Clay	210	220
(1) diameter (inches) <u>4x2</u>	Sand	220	240
(2) total depth (feet) <u>520</u>	Rock	240	242
(3) static water level (feet) <u>41</u> below top of ground.	fine sand	242	490
(4) casing <u>PVC</u> , <u>500</u> , (material) (depth)	Sand	490	520
<u>4x2</u> If telescope see back. (size)			
(5) screen <u>20</u> , <u>520-500</u> (length) (depth to top)			
<u>21</u> , <u>PVC</u> (size) (material)			
(6) pump <u>1</u> , <u>20</u> (HP) (yield gpm)			
<u>elect</u> (type power)			
(7) electric log <u>no</u> (yes or no)			
(organization running log)			
(8) how well bottom plugged <u>back press</u>			
DRILLERS REMARKS:			

DEPT. OF NATURAL RESOURCES
BUREAU OF LAND & WATER RESOURCES

MAR 22 1989

RECEIVED


If well telescopes please sketch and show depths.

GROUND LEVEL

140 4"

500 2"

520 2" scv.

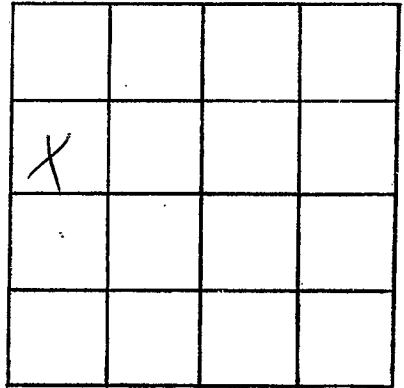

SECTION 34

Please indicate well location X.

ADDITIONAL INFORMATION

If more than one screen,
show locations of each on sketch.