

CODED

MISSISSIPPI BOARD OF WATER COMMISSIONERS  
416 North State Street  
Jackson, Mississippi 39201

WATER WELL DRILLERS LOG

SUNFLOWER  
Ø 8  
6-19-68

6-19 19 68 DYER WELLS INC. SUNFLOWER  
date well completed firm name county well located

LANDOWNER: PAUL FITZ

R.R.

MOOREHEAD  
(mailing address)

WELL LOCATION:

sec 34 T 19 N R 3 E  
1 1/2 miles EAST of MOOREHEAD  
(distance) (direction) (nearest town)

WELL PURPOSE: IRRIGATION  
(home, irrigation, municipal, industrial)

WELL COMPLETION DATA:


- (1) diameter (inches) 12"
- (2) total depth (feet) 93'
- (3) static water level (feet) 19' below top of ground.
- (4) casing DUCT 53' (material), (depth)  
12" if telescope see back. (size)
- (5) screen 40' 53' (length), (depth to top)  
12" BURLINGOT (size), (material)
- (6) pump 33 1800 (HP), (yield gpm)  
TRACTOR (type power)
- (7) electric log X (yes or no)  
(organization running log)
- (8) how well bottom plugged RATE

description of formations encountered

from to

HARD CLAY	0	15
FINE BROWN SAND	15	26
RED SAND	26	34
CHARLE SAND & GRB.	34	93

CODED

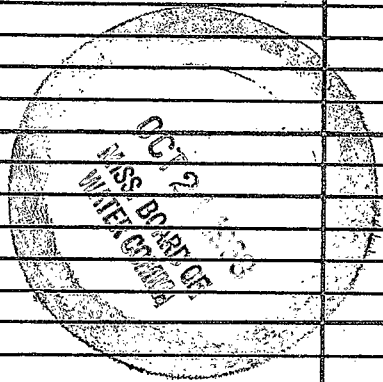

DRILLERS REMARKS:

If well telescopes please sketch and show depths.

GROUND LEVEL

X			

SECTION 34

Please indicate well location X.

ADDITIONAL INFORMATION

If more than one screen,  
show locations of each on sketch.