

Φ 11
4-24-62

WATER WELL DRILLERS LOG

CODED

Date: 4-24, 1962, Driller: BUTANE GAS CO of Wood County, LA 70091
(Name)

(1) Owner of Land: P. Himmelsstein
(Name)
MOOREHEAD, MISS
(Address)

(2) Location: 1/4, 1/4, Sec. 27 T. 19 R. 3
3 1/2 miles N. E. S. T. of MOOREHEAD
(distance) (direction) (Nearest Town)

(3) Topography: LEVEL
(Hilly) (Flat) (Level)

(4) Purpose of Well: IRRIGATION
(Domestic Irrigation
Municipal, Industrial, Other)

Description & Color of Materials Sand, Clay, Red Clay, Shell, etc.	Thick- ness Feet	Depth Feet
<u>BLUE CLAY</u>	<u>16</u>	<u>16</u>
<u>YELLOW CLAY</u>	<u>13</u>	<u>29</u>
<u>FINE SAND</u>	<u>27</u>	<u>56</u>
<u>COARSE SAND</u>	<u>8</u>	<u>64</u>
<u>PEA ROCK + C. SAND</u>	<u>9</u>	<u>73</u>
<u>C. SAND, ROCK + B. CLAY</u>	<u>9</u>	<u>82</u>
<u>BIG GRAVEL</u>	<u>35</u>	<u>117</u>

Information upon completion of well:

(1) Diameter 18 inches.

(2) Total Depth 117 feet.

(3) Water Level 10 feet below top of ground.

(4) Cased to 81, Size 18"

(5) Screen: Size 12', Length 36'


(6) Were any formations sealed against pollution?
_____ yes, X no.

If YES depth of formation _____

Why _____

Drillers Remarks: _____

CODED

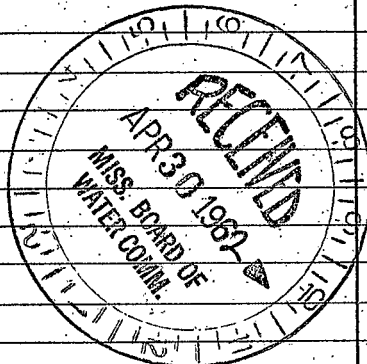

Well No.

(Use Back Side)

[The page contains extremely faint and illegible text, likely bleed-through from the reverse side of the document. The text is mostly illegible due to low contrast and blurriness.]