

SUNFLOWER
 Ø 12
 4-15-71

MISSISSIPPI
 BOARD OF WATER COMMISSIONERS
 416 North State Street
 Jackson, Mississippi 39201
 WATER WELL DRILLERS LOG

CODED

April 15, 1971 SINGER-Layne Central Division Sunflower
 date well completed firm name county well located

LANDOWNER: Ben Himelstein

Moorhead, Mississippi

(mailing address)

description of formations encountered

from

to

Clay

0

26

Fine sand

26

40

Coarse sand

40

55

Coarse sand, pea gravel

55

100

WELL LOCATION:

sec. 25 T 19 N R 3 W

4 miles west of Moorhead
 (distance) (direction) (nearest town)

WELL PURPOSE: irrigation
 (home, irrigation, municipal, industrial)

WELL COMPLETION DATA:

- (1) diameter (inches) 16"
- (2) total depth (feet) 100'
- (3) static water level (feet) 28' below top of ground.
- (4) casing steel 60' (material), (depth), 16" (size) if telescope see back.
- (5) screen 40' (length), 100' (depth to top), 16" (size), steel (material)
- (6) pump 30 (HP), 1800 (yield gpm), electric (type power)
- (7) electric log no (yes or no)

(organization running log)

(8) how well bottom plugged plate

CODED


MAY 18 1971

DRILLERS REMARKS:

REC'D. E.D. OF

If well telescopes please sketch and show depths.

GROUND LEVEL

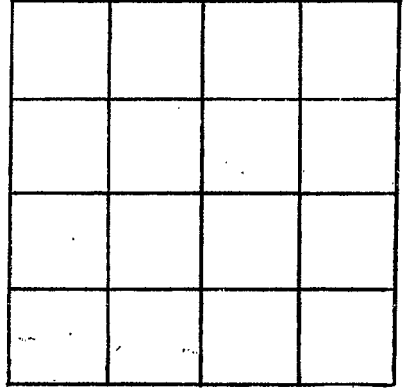

SECTION _____

Please indicate well location X.

ADDITIONAL INFORMATION

If more than one screen,
show locations of each on sketch.