

SUNFLOWER
 16
 9-28-74

MISSISSIPPI
 BOARD OF WATER COMMISSIONERS
 416 North State Street
 Jackson, Mississippi 39201

WATER WELL DRILLERS LOG **CODED**


9-28 date well completed
 Hester Drilling Co firm name
 Sunflower county/well located

LANDOWNER:	description of formations encountered	from	to
Federal Court (mailing address)	Clay fine sand pepper sand	0 50 70	50 70 110
WELL LOCATION:			
sec. 28 T. 19 N. R. 3 E $2\frac{1}{2}$ miles N of Moonraker (distance) (direction) (nearest town)			
WELL PURPOSE: Catfish (home, irrigation, municipal, industrial)			
WELL COMPLETION DATA:			
(1) diameter (inches) 16"			
(2) total depth (feet) 110			
(3) static water level (feet) 25 below top of ground.			
(4) casing steel 70' (material) (depth) 16" (size) If telescope see back.			
(5) screen 40' 70' (length) (depth to top)			
16" steel (size) (material)			
(6) pump 50 HP 2000 (yield gpm)			
Electric (type power)			
(7) electric log NO (yes or no)			
(organization running log)			
(8) how well bottom plugged Plastic			
DRILLERS REMARKS:			
No map of County			

RECEIVED
 OCT 20 1974

If well telescopes please sketch and show depths.

GROUND LEVEL

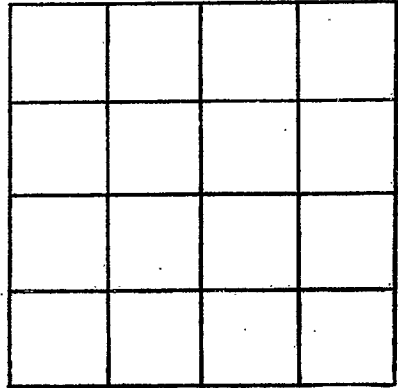

SECTION _____

Please indicate well location X.

ADDITIONAL INFORMATION

If more than one screen,
show locations of each on sketch.