

E-169

MISSISSIPPI
BOARD OF WATER COMMISSIONERS
416 North State Street
Jackson, Mississippi 39201

WATER WELL DRILLERS LOG

SUNFLOWER
0 17
8-68
Miss. Geol. Survey
AUG 9
date well completed

19 DELTA DRILLING Co.
firm name

SUNFLOWER
county well located

LANDOWNER: E.T. HAWKINS
SUNFLOWER, MISS

(mailing address)

WELL LOCATION: S1/4 SE1/4 NW1/4
sec. 5 T 19 N R 3 W
1 IN miles of SUNFLOWER
(distance) (direction) (nearest town)

description of formations encountered	from	to
GUMBO	-0-	33
Sand	33	65
GRAVEL	65	152
Sand	152	281
gumbo	281	314
Sand	314	412
gumbo	412	563
Sand	563	691
gumbo	691	799
Shale	799	855
Green sand w/rock	855	894
Shale	894	914
Sand	914	994
Shale w/rock	994	1033
BROWN Sand	1033	1073
Shale	1073	1131
gumbo	1131	1151
Sand w/ROCK	1151	1171
gumbo	1171	1190
Shale	1190	1226
Sand	1226	1237
Shale	1237	1267
Sand	1267	1269
Shale	1269	1308
Sand	1308	1314
Shale	1314	1345
Sand	1345	1362
Shale	1362	1378

WELL PURPOSE:
(home, irrigation, municipal, industrial)

WELL COMPLETION DATA:

(1) diameter (inches) 3

(2) total depth (feet) 1378

(3) static water level (feet) Flows below above top of ground.

(4) casing STEEL, 1360,
(material) (depth)
2+3" if telescope see back.
(size)

(5) screen 20', SEE BACK
(length) (depth to top)
2", S.S.
(size) (material)

(6) pump 30
(HP) (yield gpm)


(type power)

(7) electric log YES
(yes or no)

MISS GEOLOGICAL SURVEY
(organization running log)

(8) how well bottom plugged BACK
PRESSURE VALVE

DRILLERS REMARKS: 22' LAP OF
2" IN 3" PIPE - FLOWS
APPROXIMATELY 30 gpm
18'-2" TAILPIPE ON BOTTOM.

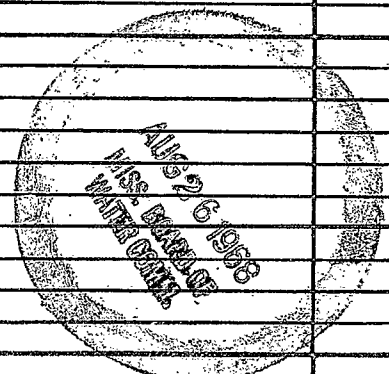

If well telescopes please sketch and show depths.

GROUND LEVEL

816'-3" BLK
API LINE
PIPE

24'-KAP OF
2" IN 3" PIPE

488'-2" BLK
API LINE PIPE

10'-2" S.S.
SCREEN

60'-2" BLK
API LINE PIPE

10'-2" S.S.
SCREEN

18'-2" BLK
API LINE PIPE

SECTION 5

Please indicate well location X.

ADDITIONAL INFORMATION

If more than one screen,
show locations of each on sketch.