

SUNFLOWER  
 027  
 5/27/78

MISSISSIPPI  
 BOARD OF WATER COMMISSIONERS  
 416 North State Street  
 Jackson, Mississippi 39201

CODED

WATER WELL DRILLERS LOG  
 BUTANE GAS COMPANY

SUNFLOWER  
 county well located

5/27/78  
 date well completed 19

OF GREENWOOD

LANDOWNER:	description of fomations encountered	from	to
Roberts Bros.			
Moorehead (mailing address)			
WELL LOCATION:			
sec. 36 T. 19 N. R. 3 E. W. 6			
3 1/2 miles NE of Moorehead (distance) (direction) (nearest town)			
WELL PURPOSE: IRR. (home, irrigation, municipal, industrial)			
WELL COMPLETION DATA:			
(1) diameter (inches) 16"			
(2) total depth (feet) 96			
(3) static water level (feet) 20 below top of ground.			
(4) casing Steel (material), (depth)			
16" (size) if telescope see back.			
(5) screen 40 (length), 56 (depth to top)			
16" (size), Steel (material)			
(6) pump 60 (HP), 2800 (yield gpm)			
Diaseal (type power)			
(7) electric log no (yes or no)			
(organization running log)			
(8) how well bottom plugged Steel pipe			
DRILLERS REMARKS:			

description of fomations encountered	from	to
Clay	0	40
FINE SAND	40	55
SAND + Pea GRAVEL	55	70
SAND + GRAVEL	70	96

CODED


RECEIVED

JUN - 1 1978

MISS. BD. OF WATER COMM

If well telescopes please sketch and show depths.

GROUND LEVEL

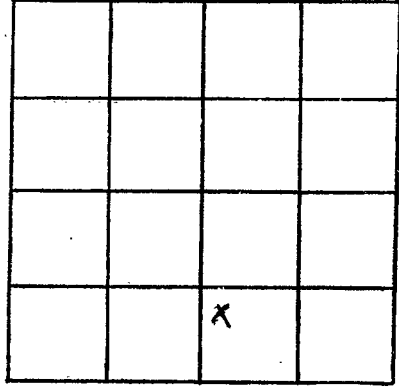

SECTION \_\_\_\_\_

Please indicate well location X.

ADDITIONAL INFORMATION

If more than one screen,  
show locations of each on sketch.