

SUNFLOWER  
 Ø 28  
 2/9/78

MISSISSIPPI  
 BOARD OF WATER COMMISSIONER CODED  
 416 North State Street  
 Jackson, Mississippi 39201  
 WATER WELL DRILLERS LOG

February 9, 1978 Dyer Well + Irrigation Sunflower  
 date well completed firm name county well located

LANDOWNER: A.B. McCarty  
 Sunflower, Miss.  
 (mailing address)  
 WELL LOCATION:  
 sec. 14 T. 19 N. R. 3 E  
 S W  
 2 miles South of Sunflower  
 (distance) (direction) (nearest town)

description of formations encountered	from	to
Clay	0	13
Clay	13	23
Clay + Fine Sand (31)	23	33
Fine Sand	33	43
Fine Sand	43	53
Fine Sand + Gravel (62)	53	63
Sand + Gravel	63	73
Sand + Gravel	73	83
Sand + Gravel	83	93
Sand + Gravel	93	103
Sand + Gravel	103	113

WELL PURPOSE: Irrigation  
 (home, irrigation, municipal, industrial)

- WELL COMPLETION DATA:
- (1) diameter (inches) 12"
  - (2) total depth (feet) 113'
  - (3) static water level (feet) 18' below top of ground.
  - (4) casing STEEL, 73' (material) (depth)  
 12" (size) if telescope see back.
  - (5) screen 40', 73' (length) (depth to top)  
 12" STEEL (size) (material)
  - (6) pump 40 HP, 2,000 (yield gpm)  
 DIESEL (type power)
  - (7) electric log No (yes or no)  
 (organization running log)
  - (8) how well bottom plugged Plate

Miss. Board of Water Comm.


FEB 8 1979

DRILLERS REMARKS:

RECEIVED

If well telescopes please sketch and show depths.

GROUND LEVEL

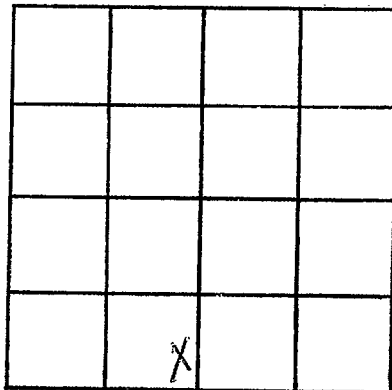

SECTION 18

Please indicate well location X.

ADDITIONAL INFORMATION

A series of horizontal lines for writing additional information, starting below the 'ADDITIONAL INFORMATION' header and extending to the bottom of the page.

If more than one screen, show locations of each on sketch.