

SUNFLOWER

Ø 31

5/22/79

MISSISSIPPI BOARD OF WATER COMMISSIONERS
416 North State Street
Jackson, Mississippi 39201

CODED

WATER WELL DRILLERS LOG

5/22 1979
date well completed

DYER WELL + IRR
firm name

SUNFLOWER
county well located

LANDOWNER:	description of formations encountered	from	to
JOHN TAYLOR MOOREHEAD (mailing address)	CLAY-	0	38
WELL LOCATION:	FINE SAND	38	48
sec. 23 T. 19 N. R. 3 E. S. W. 3 miles NE of MOOREHEAD (distance) (direction) (nearest town)	SAND	48	60
WELL PURPOSE: (home, irrigation, municipal, industrial)	SAND + GRAVEL	60	105
WELL COMPLETION DATA:			
(1) diameter (inches) 16			
(2) total depth (feet) 105			
(3) static water level (feet) 19 below above top of ground.			
(4) casing STEEL, 65 (material), (depth) 16 (size) if telescope see back.			
(5) screen 40, 65 (length), (depth to top) 16, STEEL (size), (material)			
(6) pump 40, 1800 (HP), (yield gpm) DIESEL (type power)			
(7) electric log No (yes or no)			
(organization running log)			
(8) how well bottom plugged PLATE			
DRILLERS REMARKS:			

CODED


DEPT. OF NATURAL RESOURCES
BUREAU OF LAND & WATER RESOURCES

OCT 29 1979

RECEIVED

If well telescopes please sketch and show depths.

GROUND LEVEL

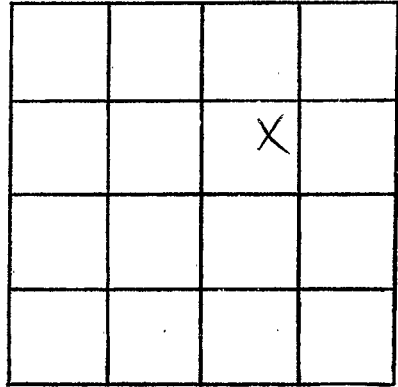

SECTION 23

Please indicate well location X.

ADDITIONAL INFORMATION

Lined area for additional information.

If more than one screen, show locations of each on sketch.