

SUNFLOWER
 Ø 32
 7/24/79

MISSISSIPPI
 BOARD OF WATER COMMISSIONERS
 416 North State Street
 Jackson, Mississippi 39201

CODED

WATER WELL DRILLERS LOG

7/24 1979 DYER WELL + IRR SUNFLOWER
 date well completed firm name county well located

LANDOWNER:
 CHAS FITTS
 MOOREHEAD
 (mailing address)

description of formations encountered	from	to
CLAY	0	28
FINE SAND	28	35
SAND	35	48
SAND & GRAVEL	48	103

WELL LOCATION:
 sec. 35 T. 18 N. R. 3 E
 19 S (W)
 2 miles N.E. of MOOREHEAD
 (distance) (direction) (nearest town)

WELL PURPOSE:
 (home irrigation, municipal, industrial)

WELL COMPLETION DATA:

(1) diameter (inches) 12"

(2) total depth (feet) 103

(3) static water level (feet) 18 below top of ground.

(4) casing STEEL 63 (material) (depth)
 12 (size) if telescope see back.

(5) screen 40 (length) (depth to top)
 12 STEEL (size) (material)

(6) pump 40 1800-2000 (HP) (yield gpm)
 ELECTRIC (type power)

(7) electric log NO (yes or no)

(organization running log)

(8) how well bottom plugged PLATE

DRILLERS REMARKS:

CODED


DEPT. OF NATURAL RESOURCES
 BUREAU OF LAND & WATER RESOURCES

OCT 29 1979

RECEIVED

If well telescopes please sketch and show depths.

GROUND LEVEL

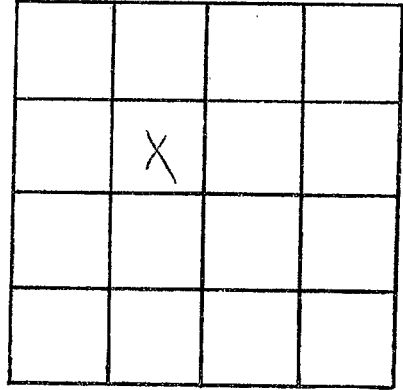

SECTION 35

Please indicate well location X.

ADDITIONAL INFORMATION

Lined area for additional information.

If more than one screen, show locations of each on sketch.