

Sunflower

MISSISSIPPI DEPARTMENT OF NATURAL RESOURCES

Bureau of Land and Water Resources

Southport Mall

P.O. Box 10631

CODED

Jackson, Mississippi 39209

WATER WELL DRILLERS LOG

0-36
7/17/80
17/47

19 80 DYER WELL + IRR - Sunflower
date well completed firm name county well located

LANDOWNER:
MS LEAWELL DEVELOPMENT CORP.
P.O. BOX 129
INVERNESS, MISS 38753
(mailing address)

description of formations encountered	from	to
CLAY	0	28
FINE SAND	28	38
SAND	38	48
SAND + GRAVEL	48	108

WELL LOCATION:
sec. 30 T 19 N R 3 E
S CW
3 1/2 miles NW of MOOREHEAD
(distance) (direction) (nearest town)

WELL PURPOSE:
(home, irrigation, municipal, industrial)

- WELL COMPLETION DATA:
- (1) diameter (inches) 16
 - (2) total depth (feet) 108
 - (3) static water level (feet) 18 below top of ground.
 - (4) casing STEEL 68 (material) (depth)
16 (size) if telescope see back.
 - (5) screen 40 68 (length) (depth to top)
16 STEEL (size) (material)
 - (6) pump 60 3000 (HP) (yield gpm)
DIESEL (type power)
 - (7) electric log N (yes or no)
(organization running log)
 - (8) how well bottom plugged STEEL PLATE

CODED

DEPT. OF NATURAL RESOURCES
BUREAU OF LAND & WATER RESOURCES


OCT - 1 1980

RECEIVED

DRILLERS REMARKS:

If well telescopes please sketch and show depths.

GROUND LEVEL

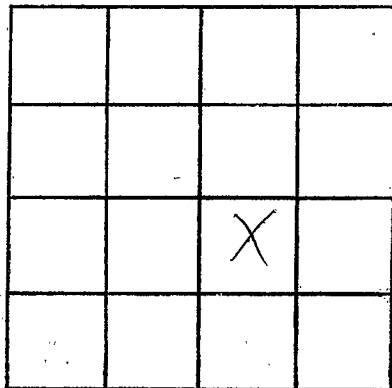

SECTION 30

Please indicate well location X.

ADDITIONAL INFORMATION

If more than one screen,
show locations of each on sketch.