

MISSISSIPPI DEPARTMENT OF NATURAL RESOURCES

Bureau of Land and Water Resources

Southport Mall

P.O. Box 10631

Jackson, Mississippi 39209

WATER WELL DRILLERS LOG

CODED

SUNFLOWER
Ø 31
8/25/80

8/25 1980 DYER WELL + IRR SUNFLOWER
 date well completed firm name county well located

LANDOWNER:
 A.B.P. INC
 40 HEAVY PARIS
 BANK OF INDIANOLA
 INDIANOLA, MISS
 (mailing address)

description of formations encountered	from	to
CLAY	0	38
SAND	38	48
SAND + GRAVEL	48	113

WELL LOCATION:
 sec. 34 T 19 N R 3 E
 S W
 2 miles N of MOOREHEAD
 (distance) (direction) (nearest town)

CODED

WELL PURPOSE:
 (home, irrigation, municipal, industrial)

WELL COMPLETION DATA:

(1) diameter (inches) 16

(2) total depth (feet) 113

(3) static water level (feet) 18 below top of ground.

(4) casing STEEL 73
 (material) (depth)
 16 If telescope see back.
 (size)

(5) screen 40 73
 (length) (depth to top)
 16 STEEL
 (size) (material)

(6) pump 40 1800
 (HP) (yield gpm)
 DIESEL
 (type power)

(7) electric log NO
 (yes or no)
 (organization running log)

(8) how well bottom plugged STEEL PLATE

DEPT. OF NATURAL RESOURCES
 BUREAU OF LAND & WATER RESOURCES


OCT - 1 1980

RECEIVED

DRILLERS REMARKS:

If well telescopes please sketch and show depths.

GROUND LEVEL

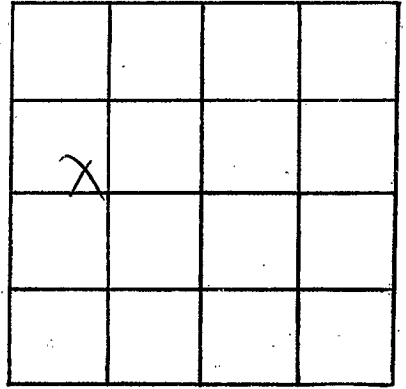

SECTION 34

Please indicate well location X.

ADDITIONAL INFORMATION

If more than one screen,
show locations of each on sketch.