

MISSISSIPPI DEPARTMENT OF NATURAL RESOURCES

Bureau of Land and Water Resources

Southport Mall

P.O. Box 10631

Jackson, Mississippi 39209

WATER WELL DRILLERS LOG

CODED

SUNFLOWER
Ø 38
8/20/80

8/20 date well completed 19 80 DYER WELL + IRR firm name SUNFLOWER county well located

LANDOWNER:  
 CHAS FITTS  
 RRI Box 173  
 MOOREHEAD MISS 38761  
 (mailing address)

description of formations encountered	from	to
CLAY	0	18
FINE SAND	18	28
SAND	28	38
SAND + GRAVEL	38	103

WELL LOCATION:  
 sec. 30 T. 19 N. R. 3  
 S. E. W.  
 2 1/2 miles NW of MOOREHEAD  
 (distance) (direction) (nearest town)

WELL PURPOSE:  
 (home, irrigation, municipal, industrial)

CODED

WELL COMPLETION DATA:

(1) diameter (inches) 12"

(2) total depth (feet) 103

(3) static water level (feet) 18 below above top of ground.

(4) casing STEEL, 63 (material) (depth)  
 12 (size) if telescope see back.

(5) screen 40, 63 (length) (depth to top)  
 12, STEEL (size) (material)

(6) pump 40, 1800 (HP) (yield gpm)  
 DIESEL (type power)

(7) electric log N/O (yes or no)  
 (organization running log)

(8) how well bottom plugged STEEL PLATE

DEPT. OF NATURAL RESOURCES  
 BUREAU OF LAND & WATER RESOURCES


OCT - 1 1980

RECEIVED

DRILLERS REMARKS:

If well telescopes please sketch and show depths.

GROUND LEVEL

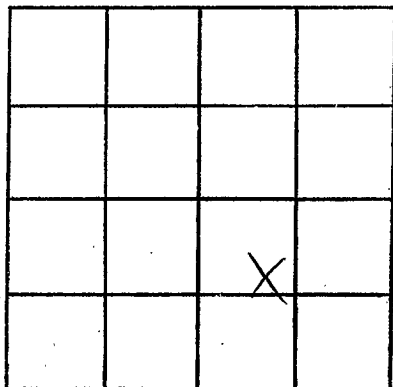

SECTION: 30

Please indicate well location X.

ADDITIONAL INFORMATION

If more than one screen,  
show locations of each on sketch.