

**SUNFLOWER**  
 042  
 5/5/80

MISSISSIPPI DEPARTMENT OF NATURAL RESOURCES  
 Bureau of Land and Water Resources  
 Southport Mall  
 P.O. Box 10631  
 Jackson, Mississippi 39209  
**WATER WELL DRILLERS LOG**

**CODED**

5/5 1980 DYER WELL + IRR SUNFLOWER  
 date well completed firm name county well located

LANDOWNER:  
 W. E. AUSTIN  
 MOOREHEAD  
 (mailing address)

description of formations encountered	from	to
CLAY	0	33
FINE SAND	33	48
SAND	48	58
SAND + GRAVEL	58	108

WELL LOCATION:  
 sec. 35 T. 19 N. R. 3 E  
 1/2 miles SE of MOOREHEAD  
 (distance) (direction) (nearest town)

WELL PURPOSE:  
 (home, irrigation, municipal, industrial)

WELL COMPLETION DATA:

(1) diameter (inches) 16  
 (2) total depth (feet) 108  
 (3) static water level (feet) 20 below top of ground.  
 (4) casing STEEL 68 (material), (depth)  
 16 (size) if telescope see back.  
 (5) screen 40 68 (length) (depth to top)  
 16 STEEL (size) (material)  
 (6) pump 40 1800 (HP) (yield gpm)  
 DIESEL (type power)  
 (7) electric log NO (yes or no)  
 (organization running log)  
 (8) how well bottom plugged STEEL PLATE

DRILLERS REMARKS:

**CODED**


DEPT. OF NATURAL RESOURCES  
 BUREAU OF LAND & WATER RESOURCES

OCT 14 1980

**RECEIVED**

If well telescopes please sketch and show depths.

GROUND LEVEL

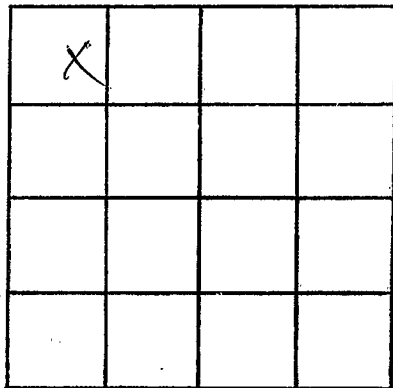

SECTION 35

Please indicate well location X.

ADDITIONAL INFORMATION

If more than one screen, show locations of each on sketch.