

SUNFLOWER

Ø 43

11/24/79

MISSISSIPPI BOARD OF WATER COMMISSIONERS  
416 North State Street  
Jackson, Mississippi 39201

CODED

WATER WELL DRILLERS LOG

11/26 1979  
date well completed

79 DYER WELL + IRR  
firm name

SUNFLOWER  
county well located

LANDOWNER:

WE, ~~REDA~~ AUSTIN

MOOREHEAD  
(mailing address)

description of formations encountered

from

to

Clay	0	28
Fine sand	28	35
Sand	35	48
Sand + Gravel	48	113

WELL LOCATION:

sec. 28 T. 19 N. R. 3 E. S. 2  
2 miles N of MOOREHEAD  
(distance) (direction) (nearest town)

WELL PURPOSE:

(home, irrigation, municipal, industrial)

WELL COMPLETION DATA:

- (1) diameter (inches) 16
- (2) total depth (feet) 113
- (3) static water level (feet) 19 <sup>below</sup> top of ground.
- (4) casing STEEL 73  
(material) (depth)  
16 (size) if telescope see back.
- (5) screen 40 73  
(length) (depth to top)  
16 STEEL  
(size) (material)
- (6) pump 60 2800  
(HP) (yield gpm)  
N.O. MOTOR ON IT  
(type power)
- (7) electric log N.O.  
(yes or no)

(organization running log)

- (8) how well bottom plugged STEEL PLATE

DRILLERS REMARKS:

CODED


DEPT. OF NATURAL RESOURCES  
BUREAU OF LAND & WATER RESOURCES

OCT 14 1980

RECEIVED

If well telescopes please sketch and show depths.

GROUND LEVEL

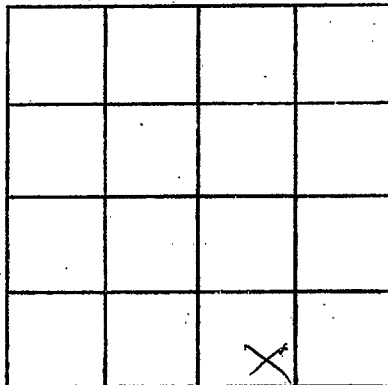

SECTION 28

Please indicate well location X.

ADDITIONAL INFORMATION

A series of horizontal lines for writing additional information.

If more than one screen, show locations of each on sketch.