

SUNFLOWER

φ 44

11/26/79

MISSISSIPPI BOARD OF WATER COMMISSIONERS
416 North State Street
Jackson, Mississippi 39201

CODED

WATER WELL DRILLERS LOG

11/26 data well completed

1979 DYER WELL #1 RR firm name

SUNFLOWER county well located

LANDOWNER:

W. R. RED AUSTIN

MOOREHEAD

(mailing address)

WELL LOCATION:

sec. 26 T. 19 N. R. 3 E. S. 1 W.
5 miles N of MOOREHEAD
(distance) (direction) (nearest town)

WELL PURPOSE:

(home, irrigation, municipal, industrial)

WELL COMPLETION DATA:

- (1) diameter (inches) 16
- (2) total depth (feet) N/A
- (3) static water level (feet) 22 below top of ground.
- (4) casing STEEL 70 (material) (depth)
16 (size) If telescope see back.
- (5) screen 40 70 (length) (depth to top)
16 STEEL (size) (material)
- (6) pump 60 280 (HP) (yield gpm)
DIESEL (type power)
- (7) electric log NO (yes or no)

(organization running log)

(8) how well bottom plugged STEEL PLATE

DRILLERS REMARKS:

description of formations encountered

from

to

Clay	0	28
Thin sand	28	35
Gravel	35	48
Sand + Gravel	48	83
Gravel	83	95
Sand + Gravel	95	110

CODED


DEPT. OF NATURAL RESOURCES
BUREAU OF LAND & WATER RESOURCES

OCT 14 1980

RECEIVED

If well telescopes please sketch and show depths.

GROUND LEVEL

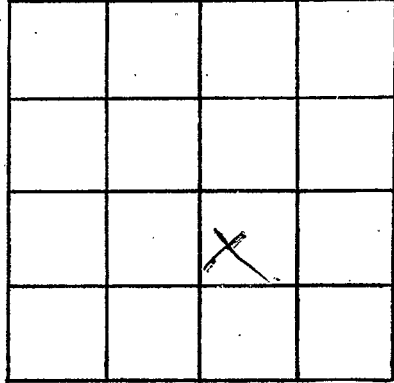

SECTION 26

Please indicate well location X.

ADDITIONAL INFORMATION

A series of horizontal lines for writing additional information.

If more than one screen, show locations of each on sketch.