

MISSISSIPPI DEPARTMENT OF NATURAL RESOURCES

Bureau of Land and Water Resources

Southport Mall

P.O. Box 10631

0069

Jackson, Mississippi 39209

WATER WELL DRILLERS LOG

CODED

Sunflower
Q 56
2-19-81

7/19 1981
date well completed

Dyer
firm name

Jackson
county well located

LANDOWNER:
B J JAMES BRADSHAW
Sunflower, MS.
(mailing address)

description of formations encountered	from	to
Clay	0	28
Fine Sand	28	
Sand	28	40
Sand & Gravel	40	96

WELL LOCATION:
sec. 2 T. 190 S. R. 3 E. W. 3
3 miles E of Sunflower
(distance) (direction) (nearest town)


WELL PURPOSE:
(home, irrigation, municipal, industrial)

WELL COMPLETION DATA:

- (1) diameter (inches) 10"
- (2) total depth (feet) 96'
- (3) static water level (feet) 20' below top of ground.
- (4) casing steel, 96' (material), (depth)
18" (size) if telescope seo back.
- (5) screen 40' 56' (length), (depth to top)
10" steel (size) (material)
- (6) pump 3.0 1000 (HP) (yield gpm)
purpose (type power)
- (7) electric log (yes or no)
(organization running log)
- (8) how well bottom plugged plate

CODED

DRILLERS REMARKS:

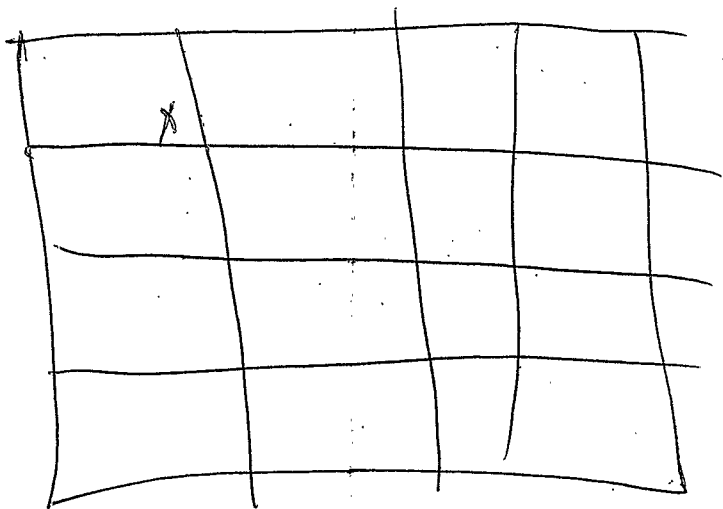

Sec 2