

MISSISSIPPI DEPARTMENT OF NATURAL RESOURCES

Bureau of Land and Water Resources

Southport Mall

P.O. Box 10331

Jackson, Mississippi 39209

WATER WELL DRILLERS LOG

W-9
CODED

Sunflower
Q. 51
2-18-81

2/18 1981 Dyer Sun.
date well completed firm name county well located

LANDOWNER:
James BRADSAW
Sunflower, MS.
(mailing address)

description of formations encountered	from	to
Clay	0	38
Fine Sand		
Sand	38	48
Sand + Gravel	48	108

WELL LOCATION:
sec. 2 T. 19 N. R. 3 E.
3 miles E of Sunflower
(distance) (direction) (nearest town)

WELL PURPOSE:
(home, irrigation, municipal, industrial)

WELL COMPLETION DATA:

(1) diameter (inches) 16

(2) total depth (feet) 108'

(3) static water level (feet) 20' below top of ground.

(4) casing (material) Steel (depth) 108'

16" if telescopic see back.
(size)

(5) screen (length) 40' (depth to top) 68'

16" Steel
(size) (material)

(6) pump 60 (HP) 3000 (yield gpm)

Panel
(type power)


(7) electric log (yes or no)

(organization running log)

(8) how well bottom plugged plate

CODED

DRILLERS REMARKS:

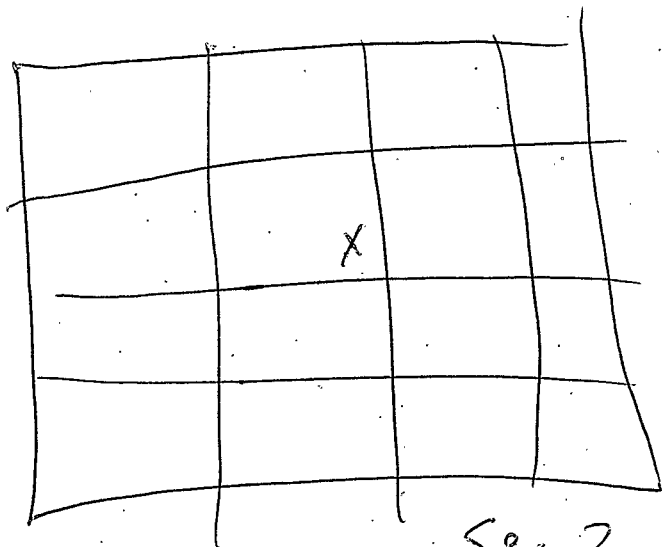

Sec 2