

MISSISSIPPI DEPARTMENT OF NATURAL RESOURCES

Bureau of Land and Water Resources

Southport Mall

P.O. Box 10631

Jackson, Mississippi 39209

WATER WELL DRILLERS LOG

CODED

Sunflower
Q58
2-19-81


2/17 1981
date well completed


Dyer
firm name

Jen
county well located

LANDOWNER:	description of formations encountered	from	to
<u>A. B. Mc CARTY</u> <u>Sunflower, MS</u> (mailing address)	<u>Clay</u> <u>fine sand</u> <u>sand</u> <u>sand & gravel</u>	<u>0</u> <u>30</u> <u>45</u> <u>58</u>	<u>30</u> <u>45</u> <u>58</u> <u>113</u>
<p>WELL LOCATION: sec. <u>18</u> T. <u>19</u> N. R. <u>3</u> E. <u>3</u> miles <u>S</u> of <u>Sunflower</u> (distance) (direction) (nearest town)</p>			
<p>WELL PURPOSE: (home, irrigation, municipal, industrial)</p>			
<p>WELL COMPLETION DATA:</p>			
<p>(1) diameter (inches) <u>16"</u></p>			
<p>(2) total depth (feet) <u>113'</u></p>			
<p>(3) static water level (feet) <u>20'</u> below above top of ground.</p>			
<p>(4) casing <u>Steel</u> <u>113'</u> (material) (depth)</p>			
<p><u>16"</u> If telescopic see back. (size)</p>			
<p>(5) screen <u>40'</u> <u>73'</u> (length) (depth to top)</p>			
<p><u>16"</u> <u>Steel</u> (size) (material)</p>			
<p>(6) pump <u>60</u> <u>3000</u> (HP) (yield gpm)</p>			
<p><u>Steel</u> (type power)</p>			
<p>dc log (yes or no)</p>			
<p>(organizational) (naming log)</p>			
<p>(8) how well bottom plugged <u>plate</u></p>			
<p>DRILLERS REMARKS:</p>			

CODED

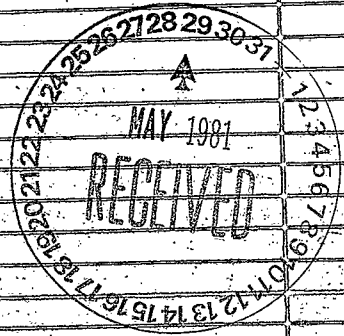

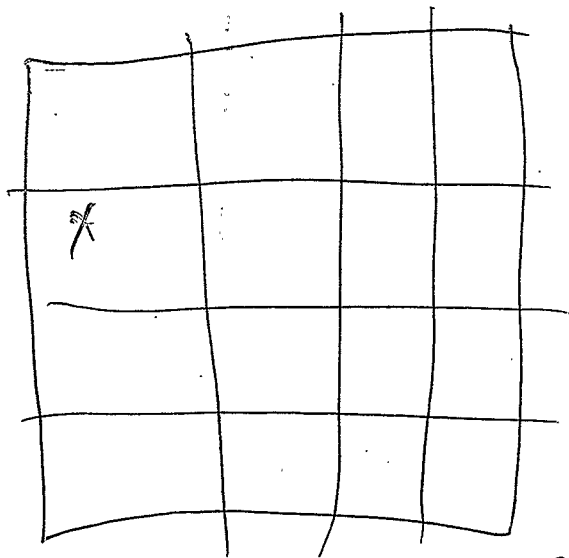

Sec 19