

Bureau of Land and Water Resources

Southport Mall

P.O. Box 10631

3363

Jackson, Mississippi 39209

WATER WELL DRILLERS LOG CODED

Surface  
Q 59  
12-4-80

12/4/80 date well completed      Dyer firm name      Sum. county well located

LANDOWNER:  
PETE FISHER  
(BIG D) Sulfaver, MS.  
(mailing address)

description of formations encountered

description of formations encountered	from	to
<u>0-33' Top Soil + Clay</u>		
<u>33-73' Sand</u>		
<u>73-113' fine S sand</u>		

WELL LOCATION:  
sec. 26 T. 19 N. R. 3 E. S. 3  
3 miles W of Sulfaver  
(distance) (direction) (nearest town)

WELL PURPOSE:  
(home, irrigation, municipal, industrial)

WELL COMPLETION DATA:

(1) diameter (inches) 16"

(2) total depth (feet) 113'

(3) static water level (feet) 20' below above top of ground.

(4) casing Steel 113'  
(material) (depth)

16" if telescope see back.  
(size)

(5) screen 40' 73'  
(length) (depth to top)

16" Steel  
(size) (material)

(6) pump 125 1200  
(HP) (yield gpm)


Diesel  
(type power)

(7) electric log (yes or no)


(organization running log)

(8) how well bottom plugged plate

CODED

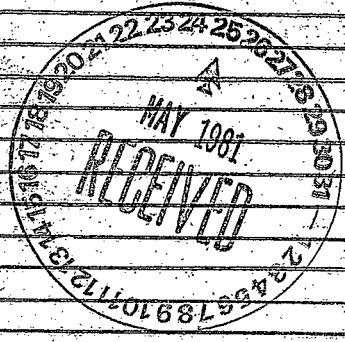

DRILLERS REMARKS:

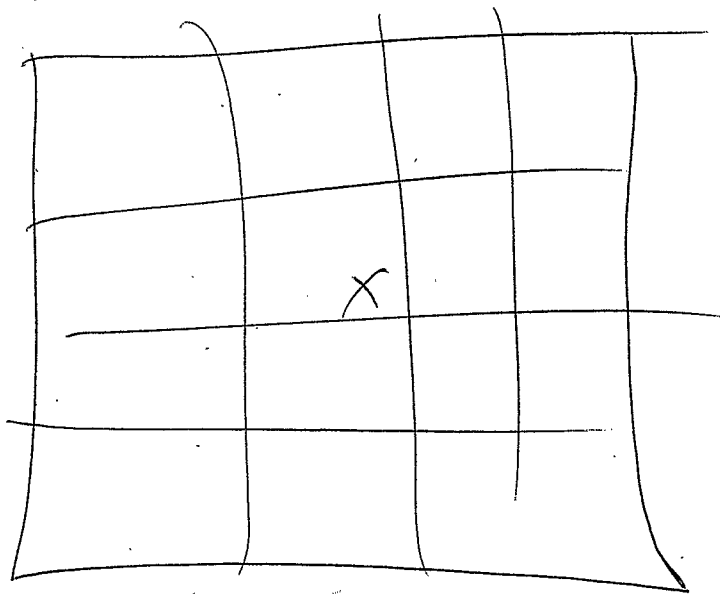

See 26