

Sunflower  
Q.60  
2-14-80

MISSISSIPPI  
 BOARD OF WATER COMMISSIONERS  
 416 North State Street  
 Jackson, Mississippi 39201

CODED

WATER WELL DRILLERS LOG

2/14 1980 Dyer Sum.  
 date well completed firm name county well located

LANDOWNER:  
JAMES BRADSHAW  
AZALEA ST INDIANOLA  
 (mailing address)


description of formations encountered	from	to
<u>Clay</u>	<u>0</u>	<u>38</u>
<u>MS. Fine Sand</u>	<u>31</u>	<u>45</u>
<u>Sand</u>	<u>45</u>	<u>58</u>
<u>Sand &amp; Gravel</u>	<u>58</u>	<u>102</u>

WELL LOCATION:  
 sec. 2 T-19 N R-3 E  
3 miles E of Sunflower  
 (distance) (direction) (nearest town)

WELL PURPOSE:  
 (home, irrigation, municipal, industrial)

WELL COMPLETION DATA:  
 (1) diameter (inches) 16"  
 (2) total depth (feet) 102'  
 (3) static water level (feet) 20' below above top of ground.  
 (4) casing Steel 102'  
 (material) (depth)  
16" If telescope see back.  
 (size)  
 (5) screen 40' 62'  
 (length) (depth to top)  
16" Steel  
 (size) (material)  
 (6) pump 60 3000  
 (HP) (yield gpm)  
Diesel  
 (type power)  
 (7) electric log (yes or no)  
 (organization running log)  
 (8) how well bottom plugged plate


CODED

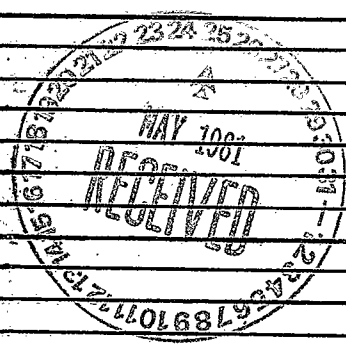

DRILLERS REMARKS:

If well telescopes please sketch and show depths.

GROUND LEVEL

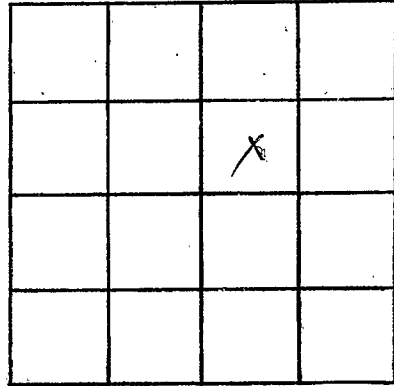

SECTION 2

Please indicate well location X.

ADDITIONAL INFORMATION

If more than one screen, show locations of each on sketch.

Handwritten notes in the additional information section, including "Road to ...", "1 or 2 ...", and "2 - ...".

686-2246

Handwritten signature and notes at the bottom right of the page.